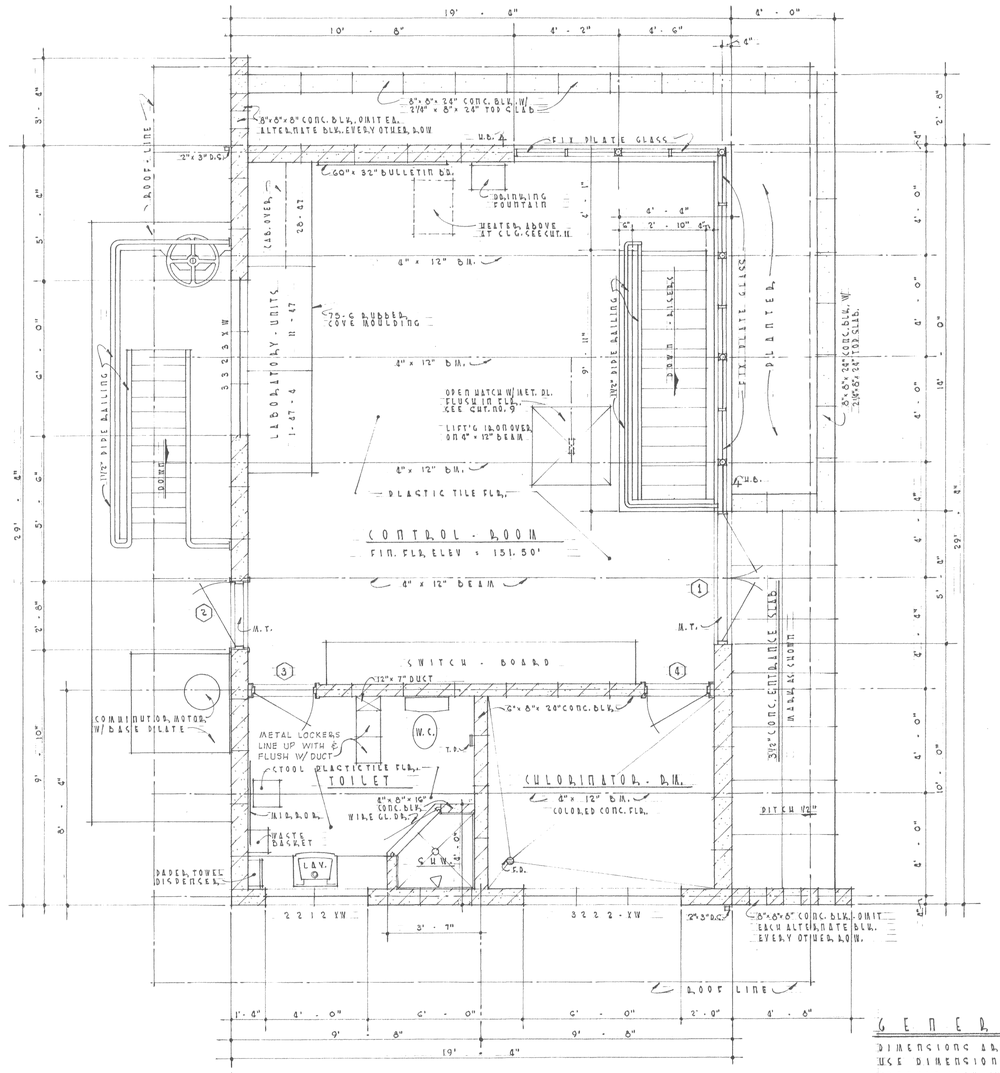


FLOOR - PLAN

SCALE = 3/8" = 1' - 0"

GENERAL - NOTES

DIMENSIONS ARE TAKEN FROM FACE TO ℄ OF MASONRY USE DIMENSIONS IN PREFERANCE TO SCALE CONSULT ARCH. IF DISCREPANCY OCCURS BEFORE PROCEEDING WITH WORK.

NORTH

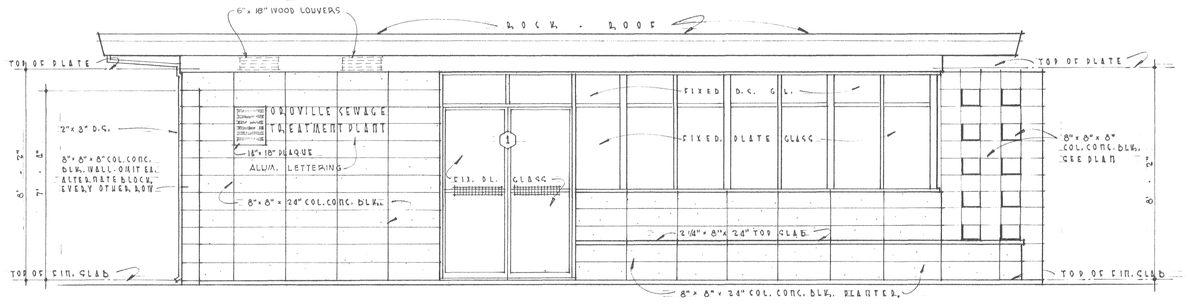


EAST - ELEVATION

SCALE = 3/8" = 1' - 0"

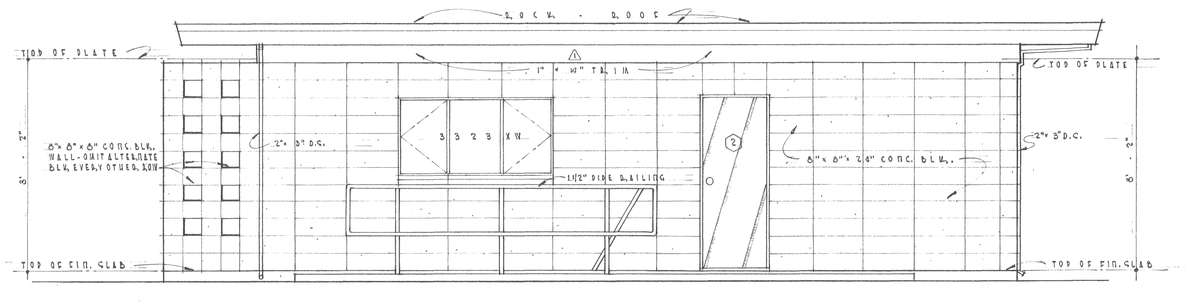


WEST - ELEVATION

SCALE = 3/8" = 1' - 0"

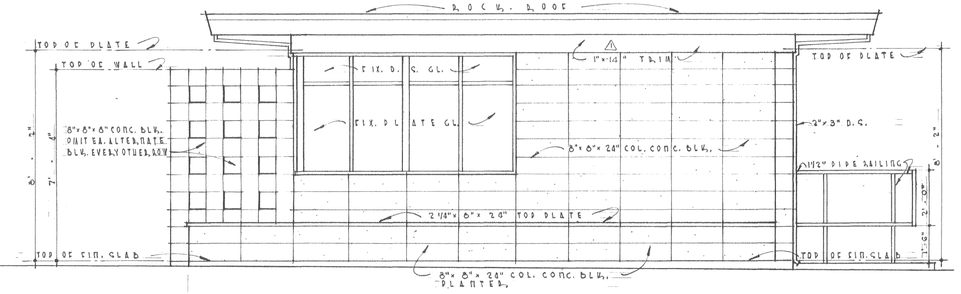


NORTH - ELEVATION

SCALE = 3/8" = 1' - 0"

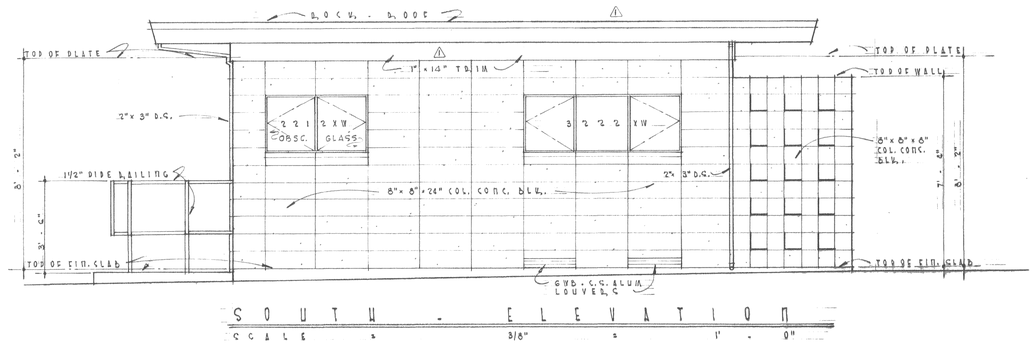


SOUTH - ELEVATION

SCALE = 3/8" = 1' - 0"

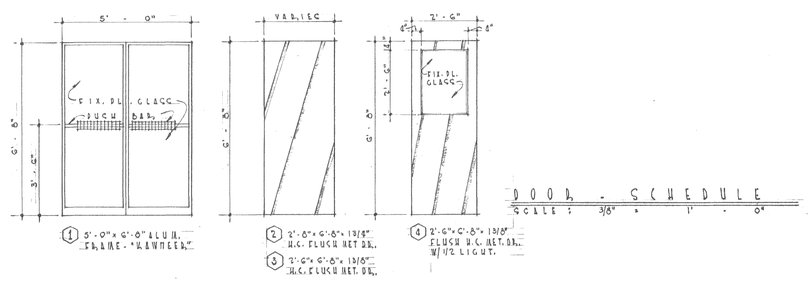


1. 5'-0" x 6'-0" ALUM. FRAME - "RAWNEER"
2. 2'-8" x 6'-8" x 13/8" H.C. FLUSH MET. DR.
3. 2'-6" x 6'-8" x 13/8" H.C. FLUSH MET. DR.
4. 2'-6" x 6'-8" x 13/8" FLUSH H.C. MET. DR. W/ 1/2 LIGHT.

DOOR - SCHEDULE

SCALE : 3/8" = 1' - 0"

AS BUILT

| REVISION | DATE | DESCRIPTION | BY | APP |
|---|---|---|---|---|
| ⚠ A.B. | 5-1-61 | Relocated louvers Changed trim size. | RAB. | |

CITY OF OROVILLE
BUTTE COUNTY, CALIFORNIA

SEWAGE TREATMENT PLANT

# CONTROL BUILDING ARCHITECTURAL

DEWANTE AND STOWELL
SANITARY AND CIVIL ENGINEERS — SACRAMENTO, CALIFORNIA

DRAWN: G.C.S.
CHECKED: R.H.D.
DATE: Mar. 1959
SUBMITTED:
APPROVED:
SHEET NO. 15 OF 36

RICKEY & BROOKS • KENNETH C. RICKEY • ARCHITECT A•I•A• 2015 J ST. SACRAMENTO, CALIF • DI 6-0331

DRAWN: G.C. STAMAS

LIETZ 1118 TOPFLIGHT 300 1-59

SS 157