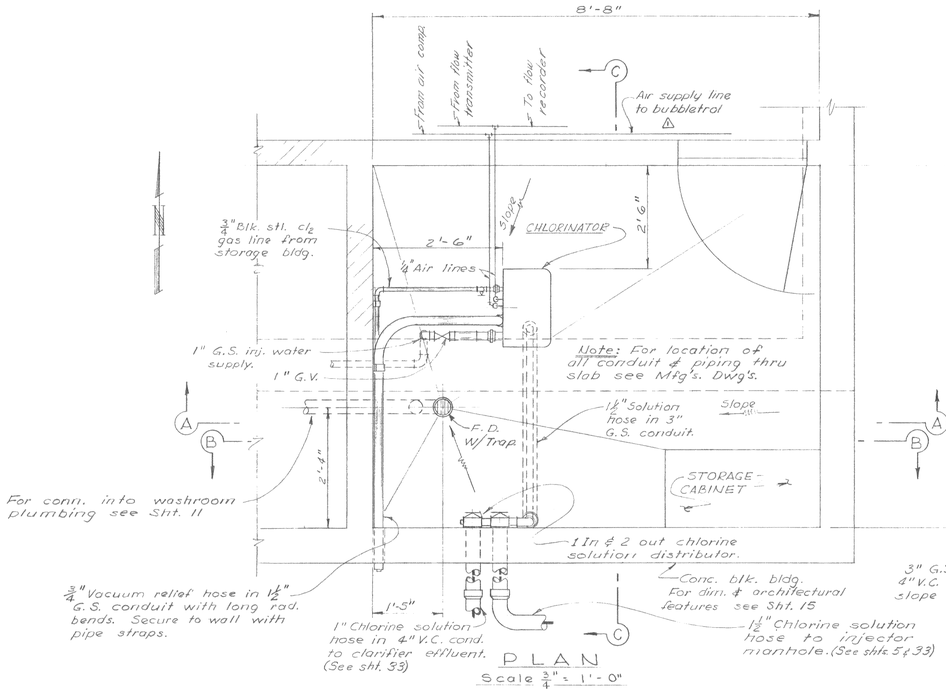

PLAN

Scale 3/4" = 1'-0"

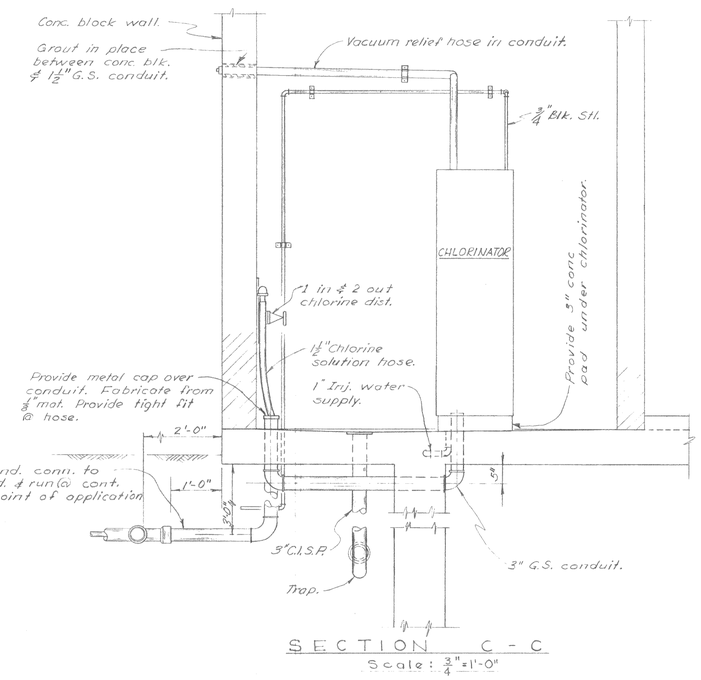

SECTION C - C

Scale: 3/4" = 1'-0"

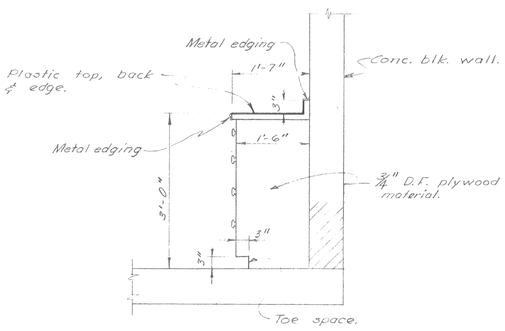

SECTION D - D

Scale: 3/4" = 1'-0"

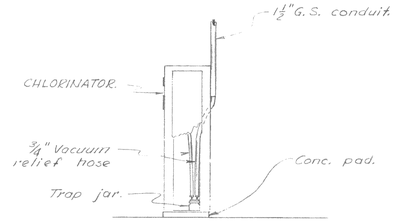

TRAP JAR DETAIL

Scale: None.

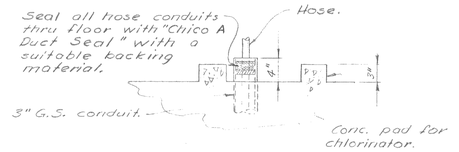

CONDUIT SEAL DETAIL

Scale: None.

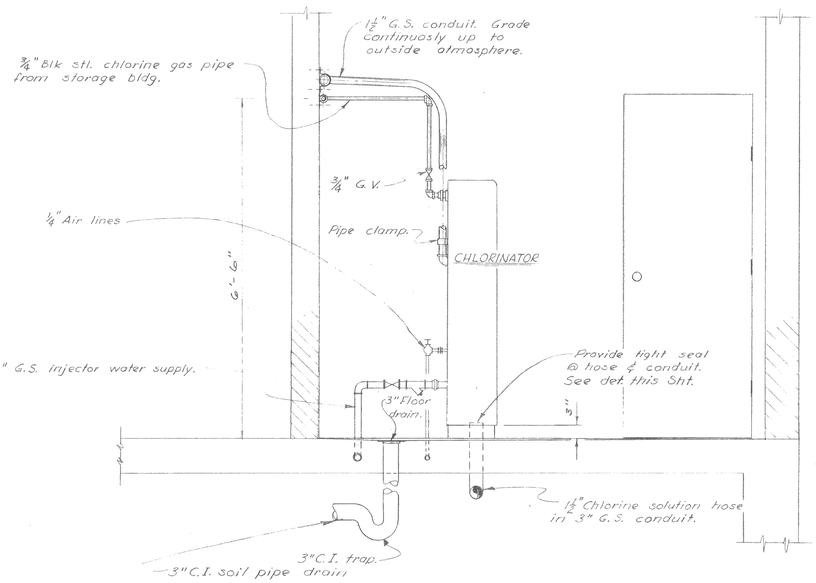

SECTION A - A

Scale: 3/4" = 1'-0"

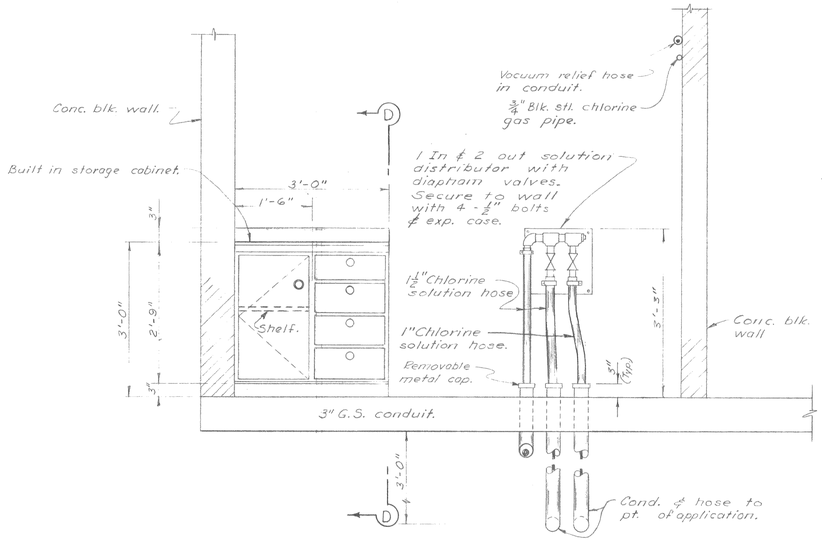

SECTION B - B

Scale: 3/4" = 1'-0"

AS BUILT

REVISION	DATE	DESCRIPTION	BY	APP
⚠ A.B.	5-1-61	Added air line.	R.A.B.	

CITY OF OROVILLE
BUTTE COUNTY, CALIFORNIA

SEWAGE TREATMENT PLANT

CHLORINATOR ROOM

DEWANTE AND STOWELL
SANITARY AND CIVIL ENGINEERS — SACRAMENTO, CALIFORNIA

DRAWN: J.D.J.
CHECKED: R.H.D.
DATE: Mar. 1959
SUBMITTED:
APPROVED:
SHEET NO. 10 OF 36

SS 157