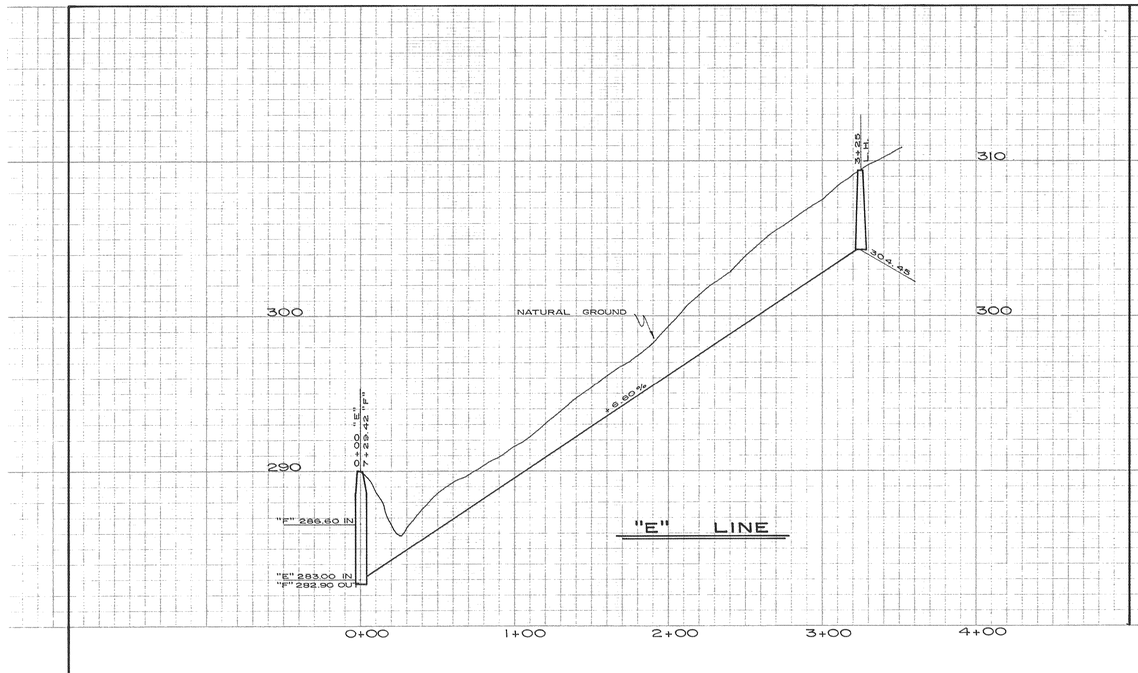

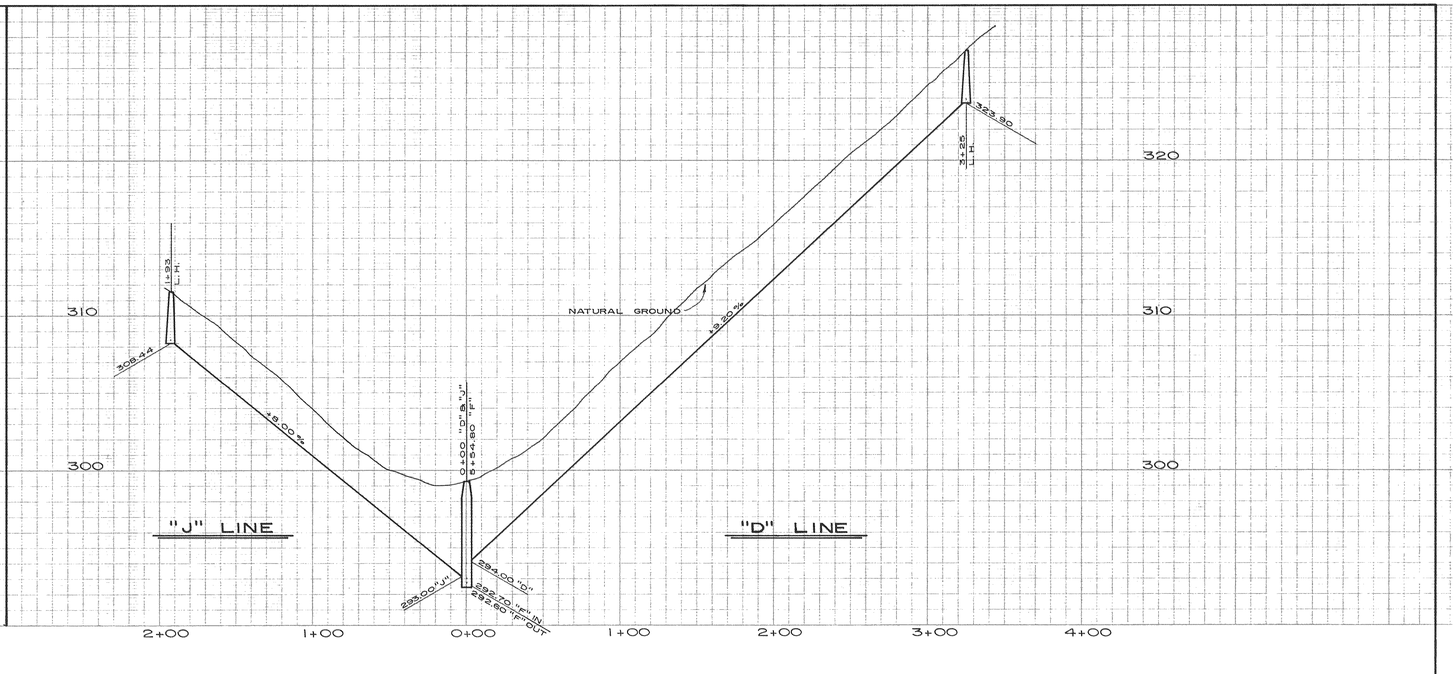

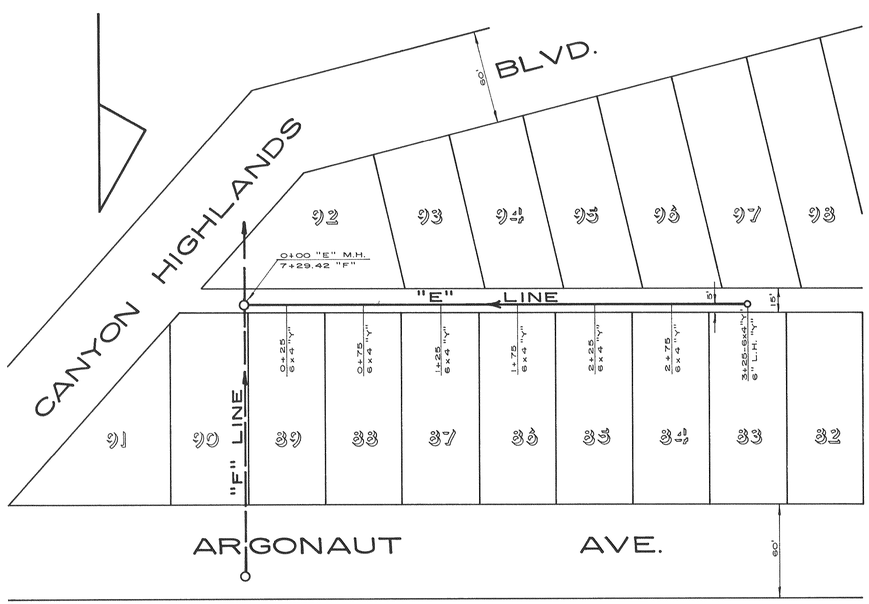

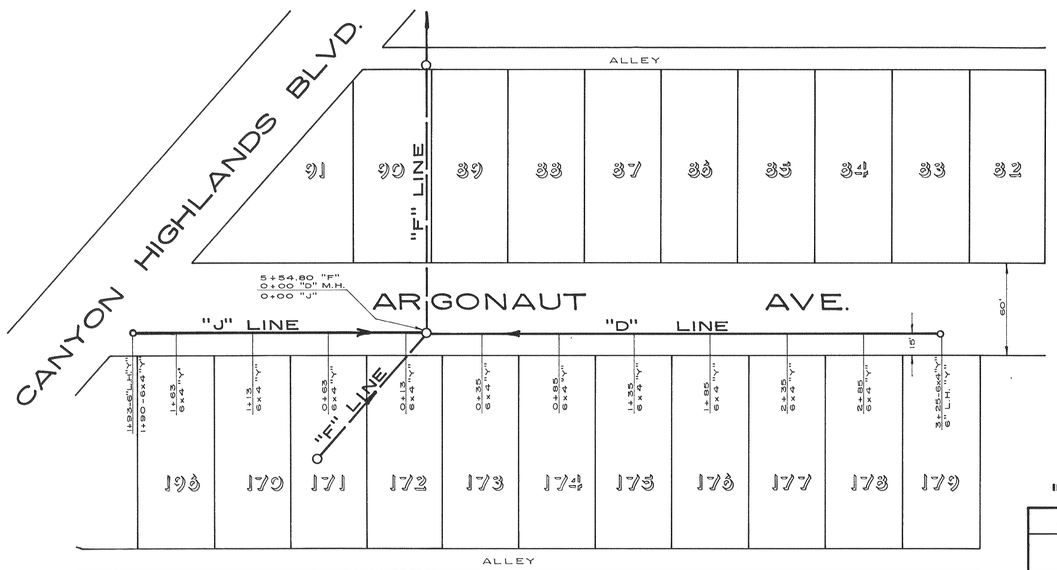

REDRAWN ON LINEN—1/29/70—N.A.W.

"D","E" & "J" LINE

GRAND VIEW SUBDIVISION

CITY OF OROVILLE

SANITARY SEWER
ARGONAUT AVENUE
WEST OF
CANYON HIGHLANDS BLVD.

SS-116