


Grand View Subdivision Sewer Plat.

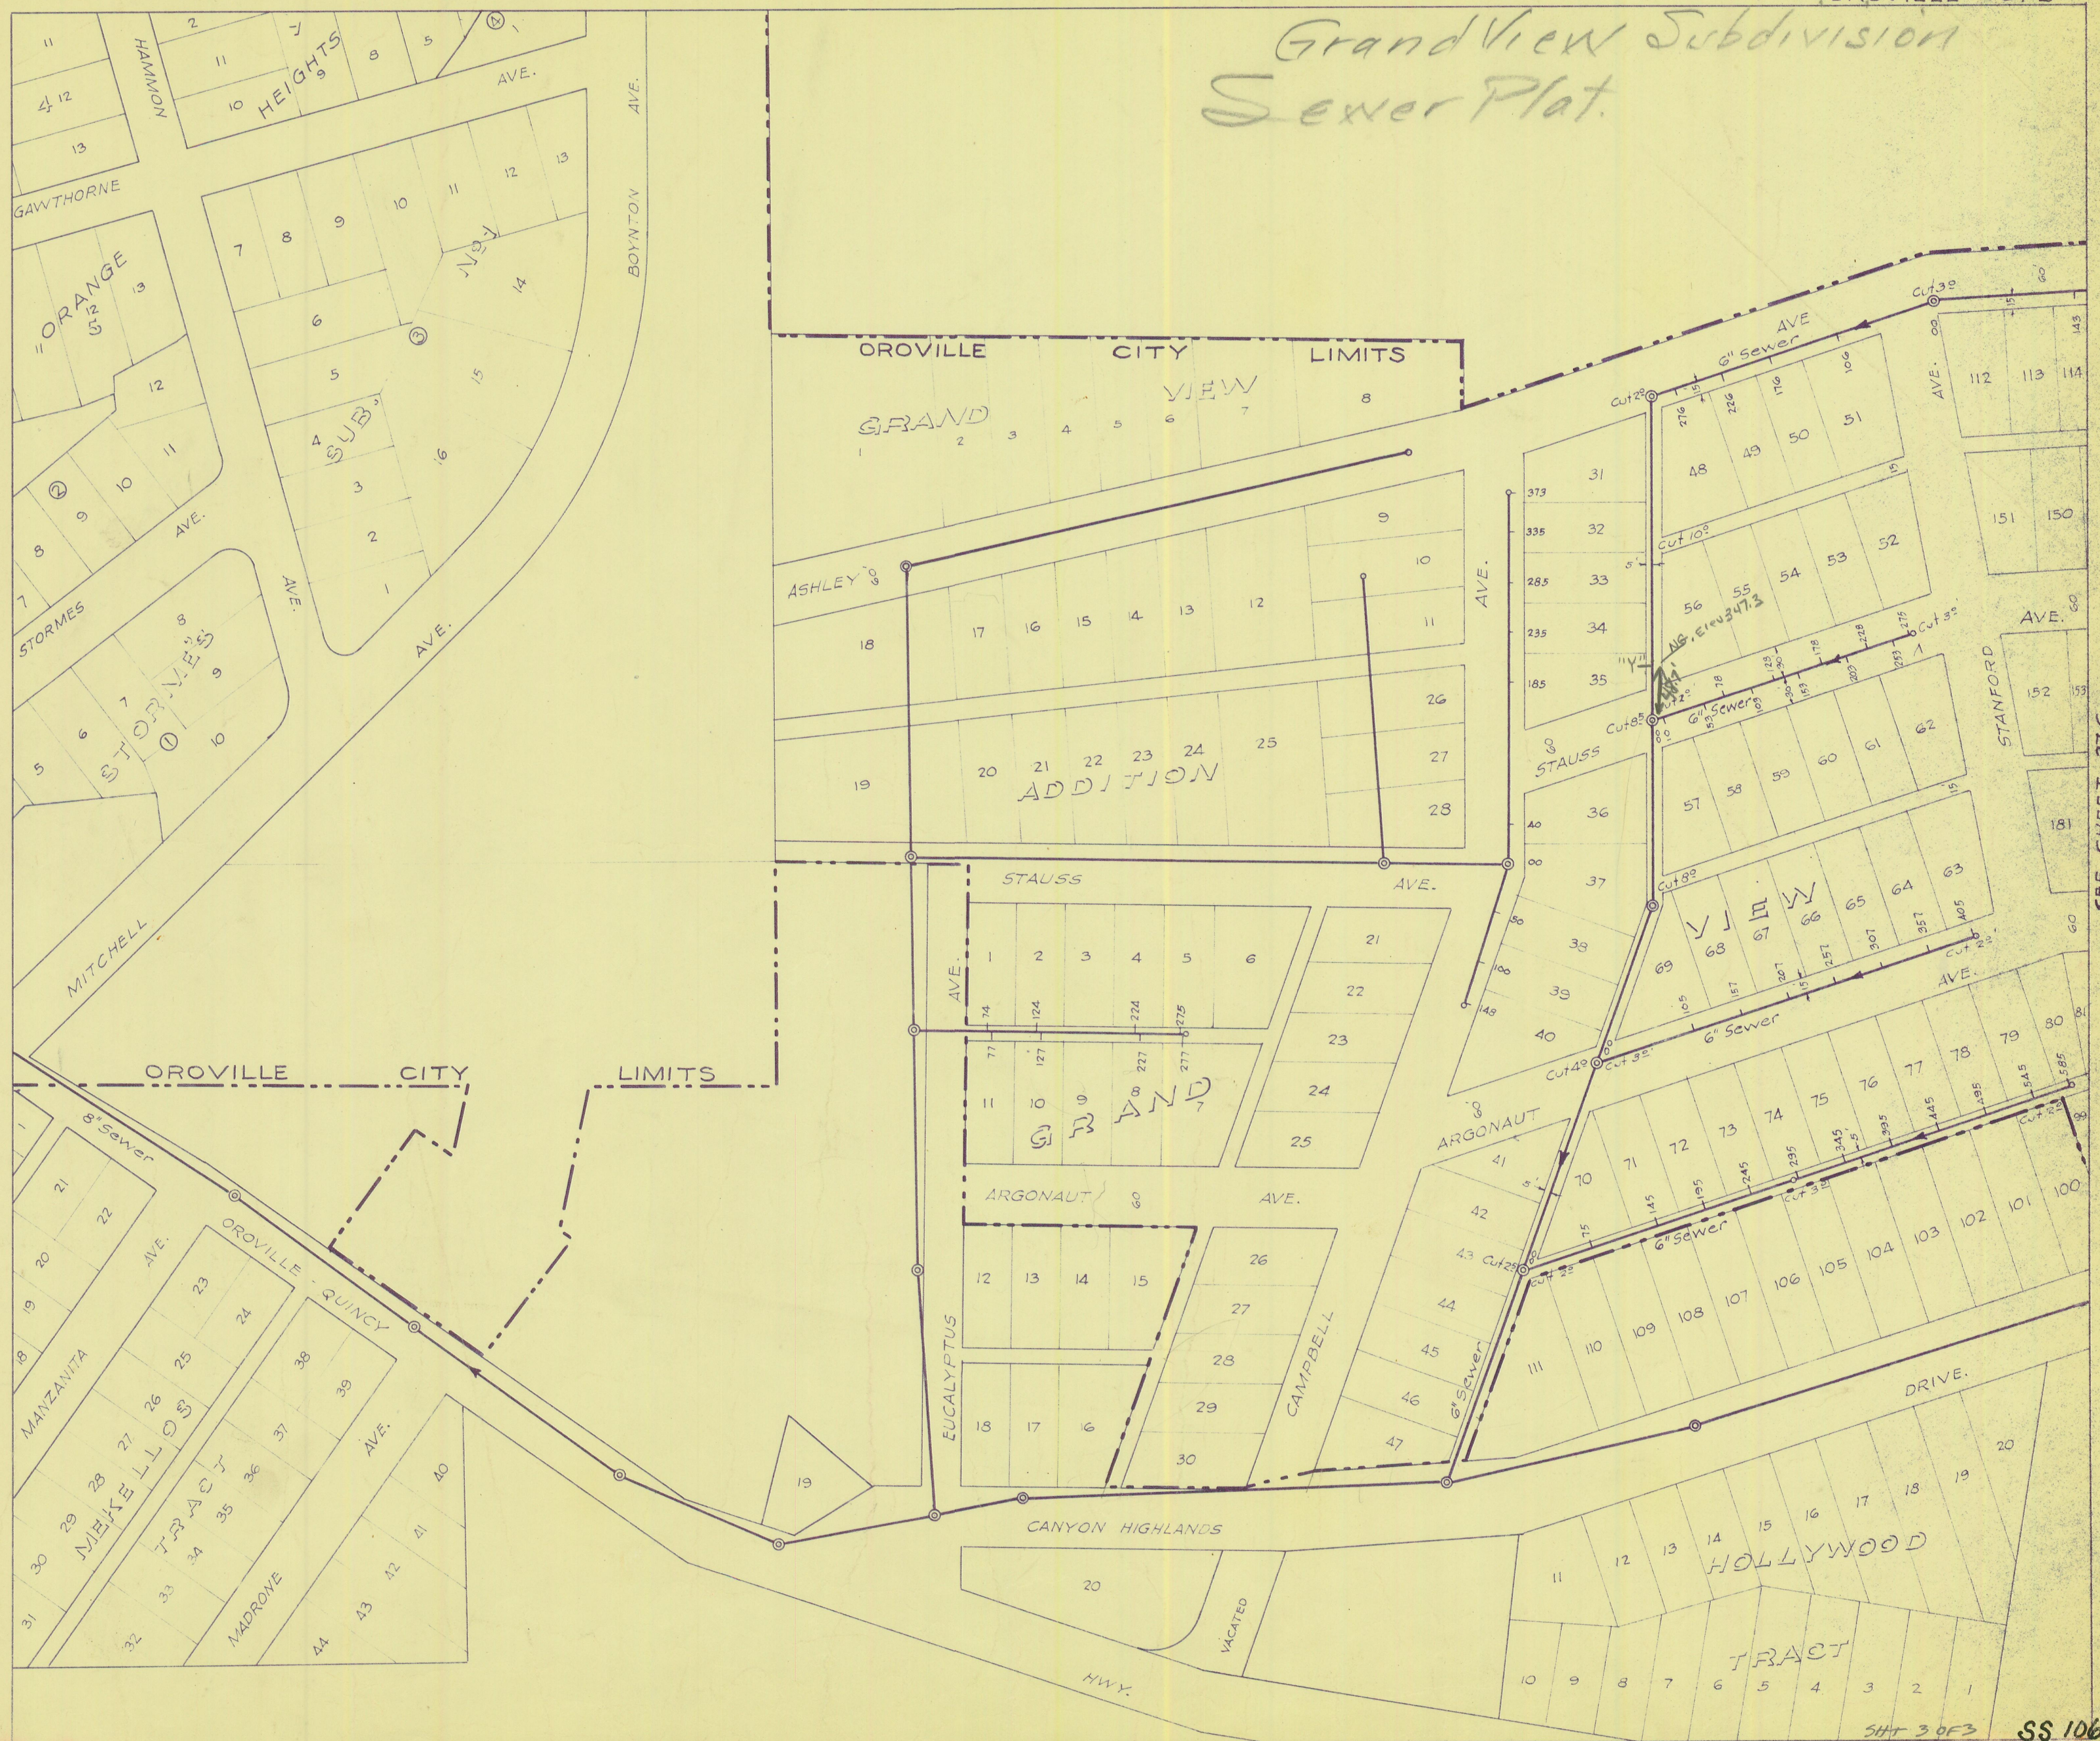

SEE SHEET 37C