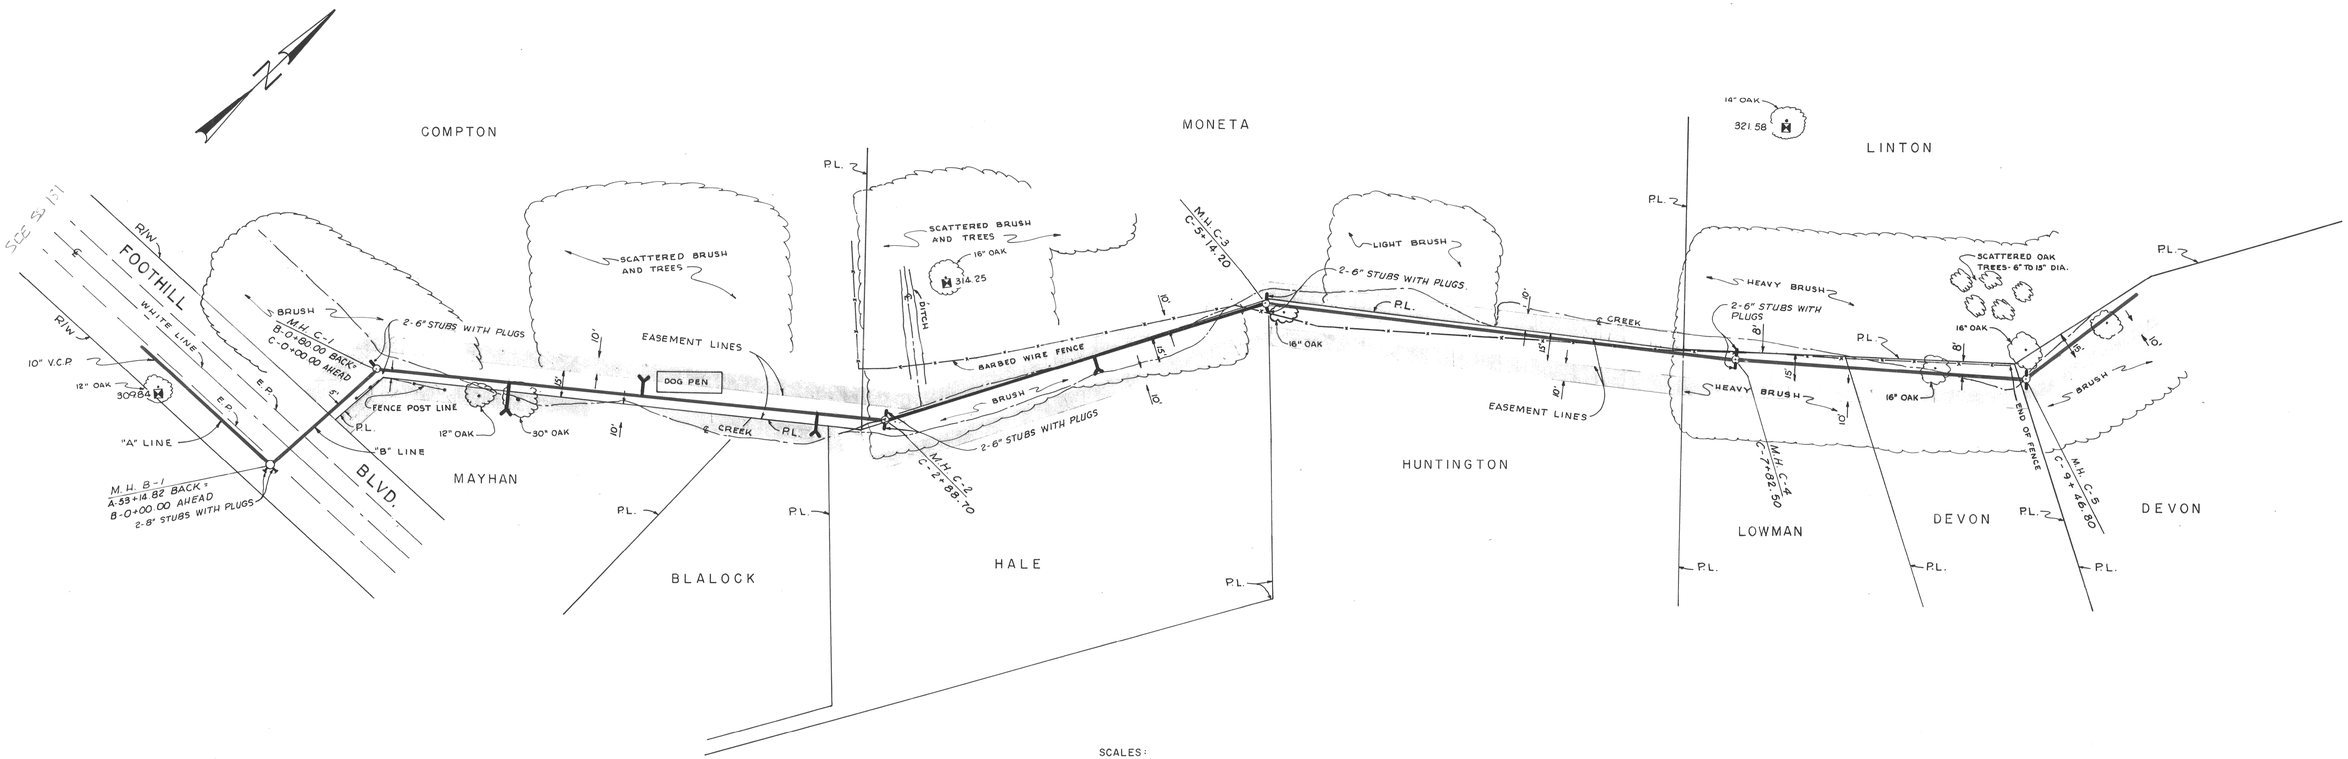

SCALES:
HORIZONTAL : 1" = 40'
VERTICAL : 1" = 4'

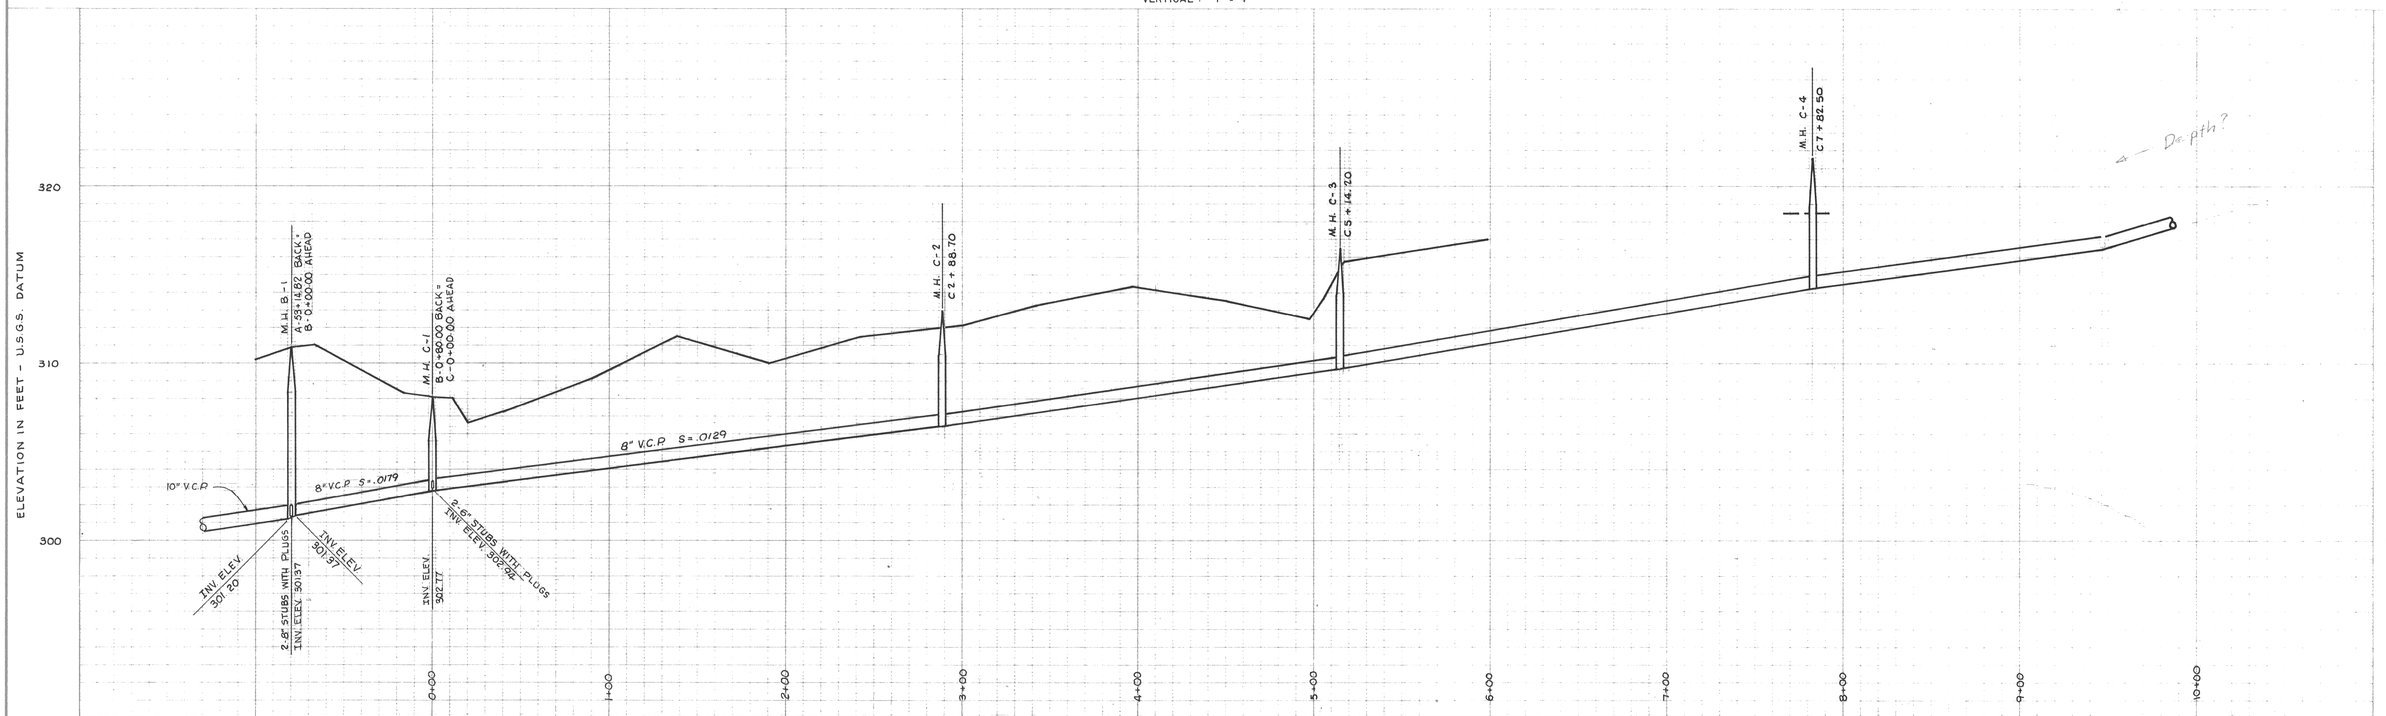

DEWANTE AND STOWELL
SANITARY AND CIVIL ENGINEERS — SACRAMENTO, CALIFORNIA

REVISION	DATE	DESCRIPTION	BY	APPD

SUBMITTED Edwin R. Stowell
APPROVED Harold Greeson

CITY OF OROVILLE
OROVILLE, CALIFORNIA

FOOTHILL BOULEVARD-GLEN DRIVE SEWER MAIN EXTENSION

PLAN AND PROFILE - "B" & "C" LINE

DATE: July 26, 1962
CHKD: E.R.S.
DRAWN: R.A.B.
SHEET 8 OF 14

SS 237