

APPROVALS

APPROVED FOR CONSTRUCTION ON
THIS 2ND DAY OF JULY, 1973
BY ROBERT WINSTON, MAYOR OF THE
CITY OF OROVILLE, CALIFORNIA.


Robert Winston
ROBERT WINSTON, MAYOR

APPROVAL RECOMMENDED ON
THIS 2ND DAY OF JULY, 1973
BY JERROLD GONCE, CITY ADMINISTRATOR
OF THE CITY OF OROVILLE, CALIFORNIA.

Jerrold Gonce
JERROLD GONCE, CITY ADMINISTRATOR

PERMITTED FOR APPROVAL BY HAROLD
KROEGER, DIRECTOR OF PUBLIC WORKS
OF THE CITY OF OROVILLE, CALIFORNIA

Harold Kroeger
HAROLD KROEGER, DIRECTOR OF PUB. WORKS.

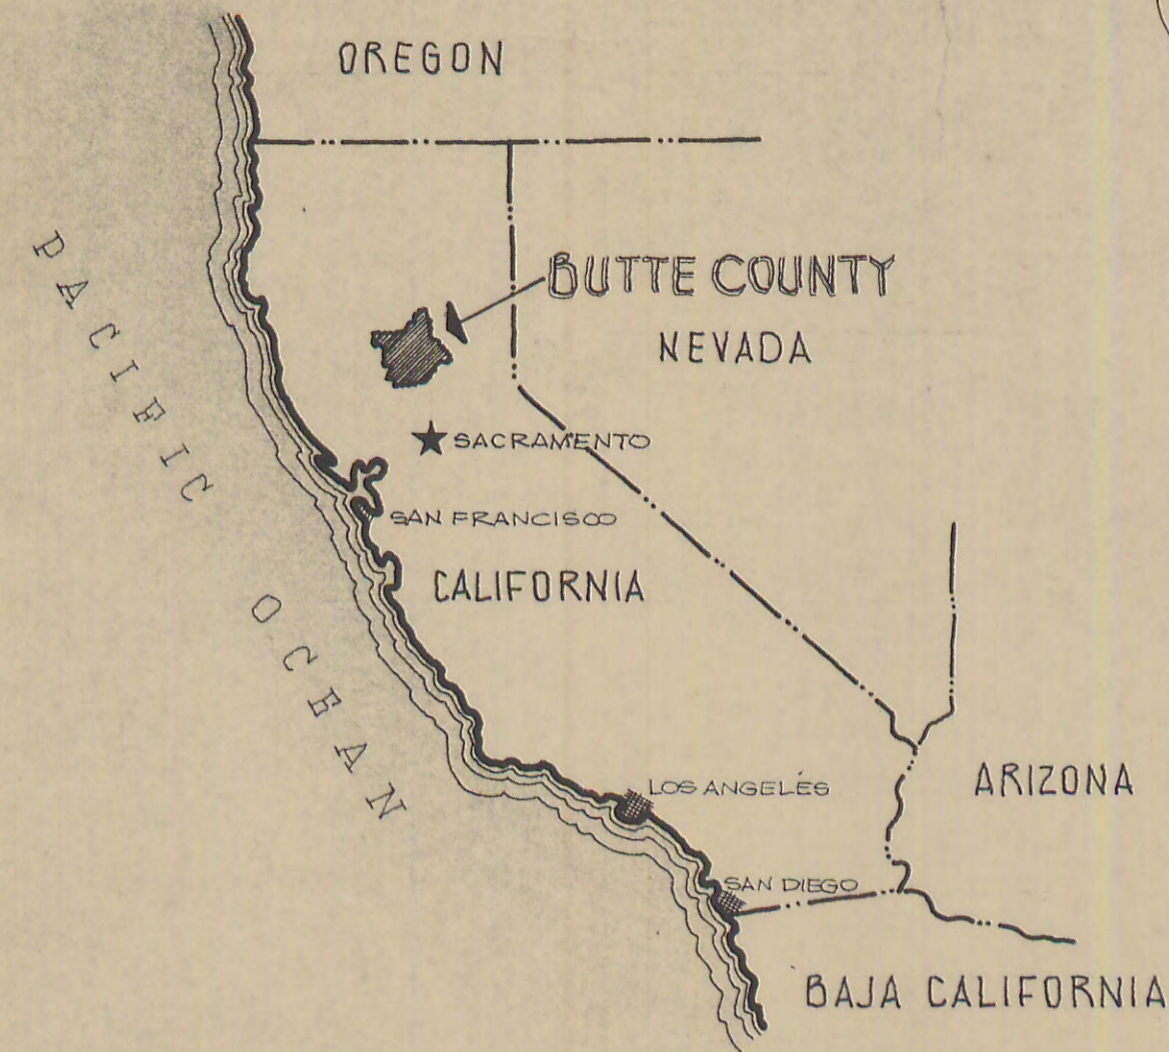

PLANS
FOR THE CONSTRUCTION OF
SANITARY SEWER IMPROVEMENTS
FOR
VALLEY VIEW NO. 1,
VALLEY VIEW NO. 2 &
CANYON HIGHLANDS DRIVE NO. 1

City of Oroville
BUTTE COUNTY, CALIFORNIA

SHEET INDEX




SHEET TITLE	SHEET NO.
TITLE SHEET	1
PLAN PROFILE	2-3
CONSTRUCTION DETAILS	4-5



GENERAL NOTES

- EXISTING UNDERGROUND PUBLIC UTILITIES
 - WATER—OROVILLE WYANDOTTE IRRIGATION DISTRICT, OROVILLE
 - NATURAL GAS — P.G. & E.
- PLAN VIEWS SHOWN ARE FROM PHOTO'S TAKEN IN MAY OF 1971.

Contractor agrees that he shall assume sole and complete responsibility for job site conditions during the course of construction of this Project, including safety of all persons and property; that this requirement shall apply continuously and not be limited to normal working hours; and that the Contractor shall defend, indemnify and hold the Owner and the Engineer harmless from any and all liability, real or alleged, in connection with the performance of work on this Project, excepting for liability arising from the sole negligence of the Owner or the Engineer.

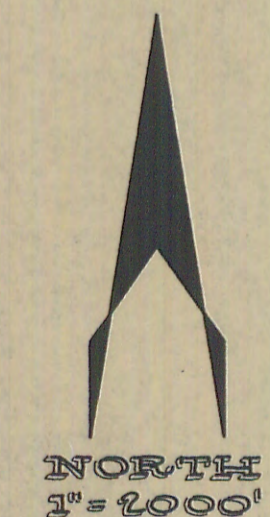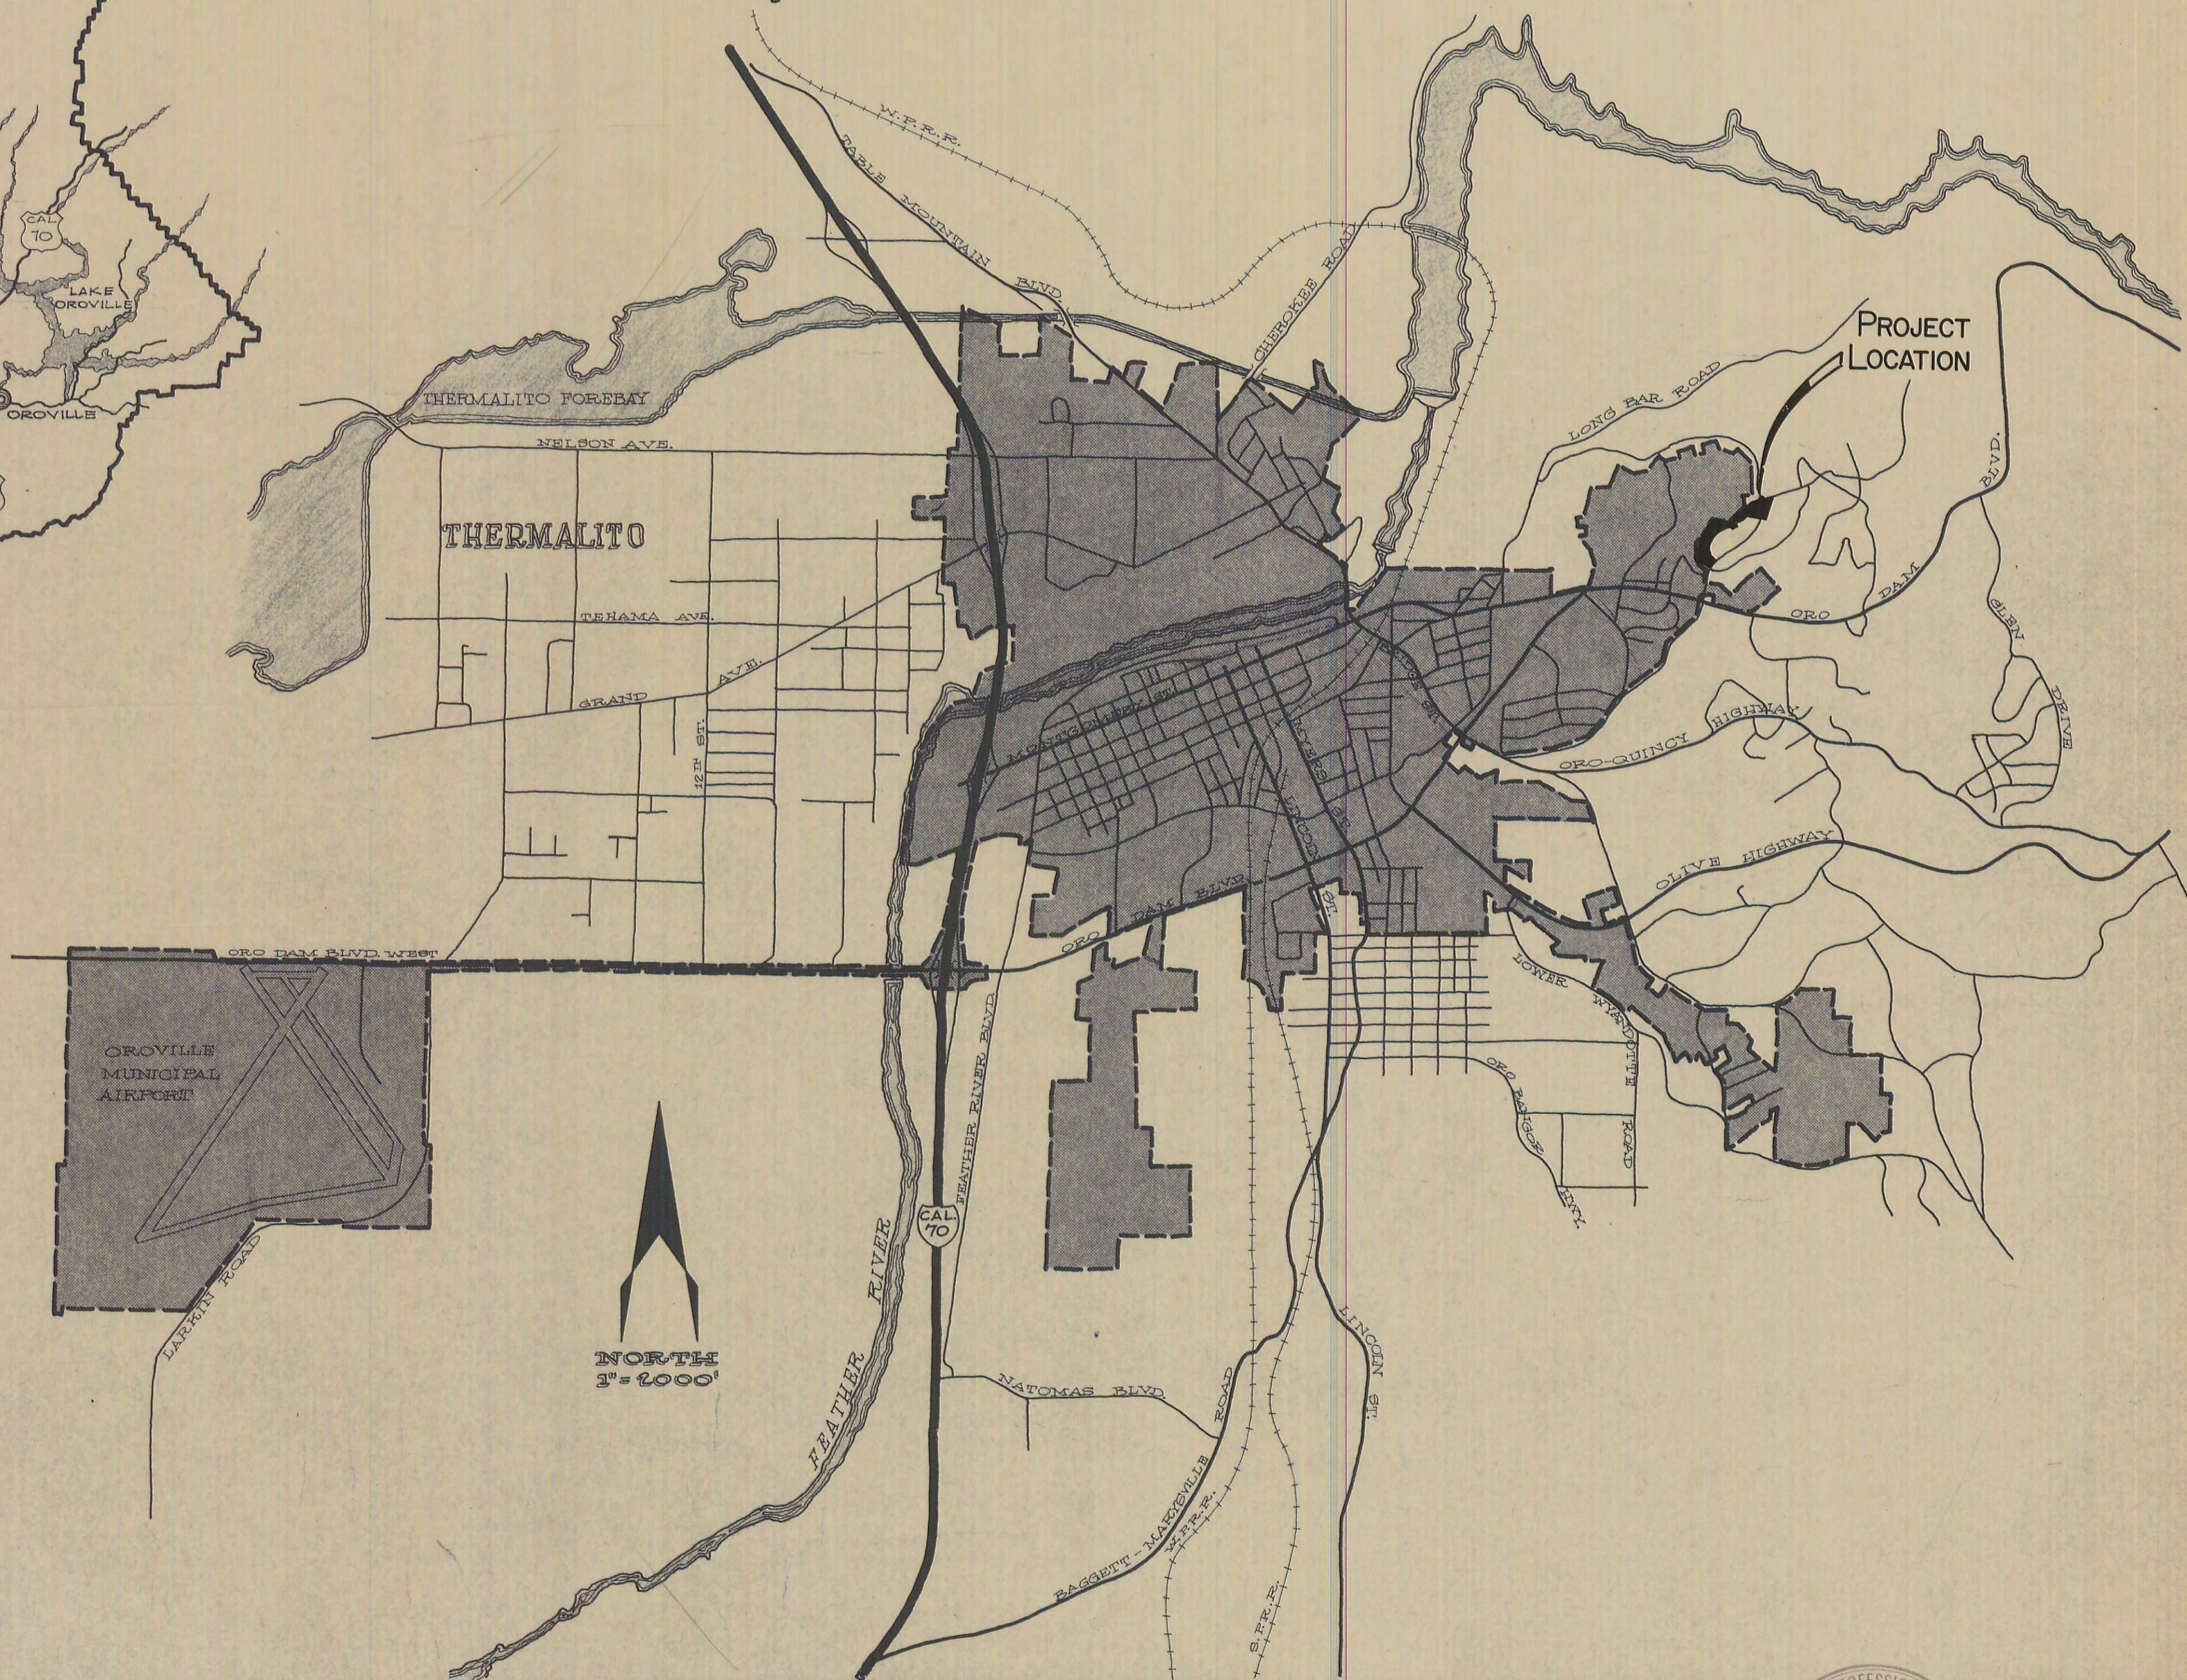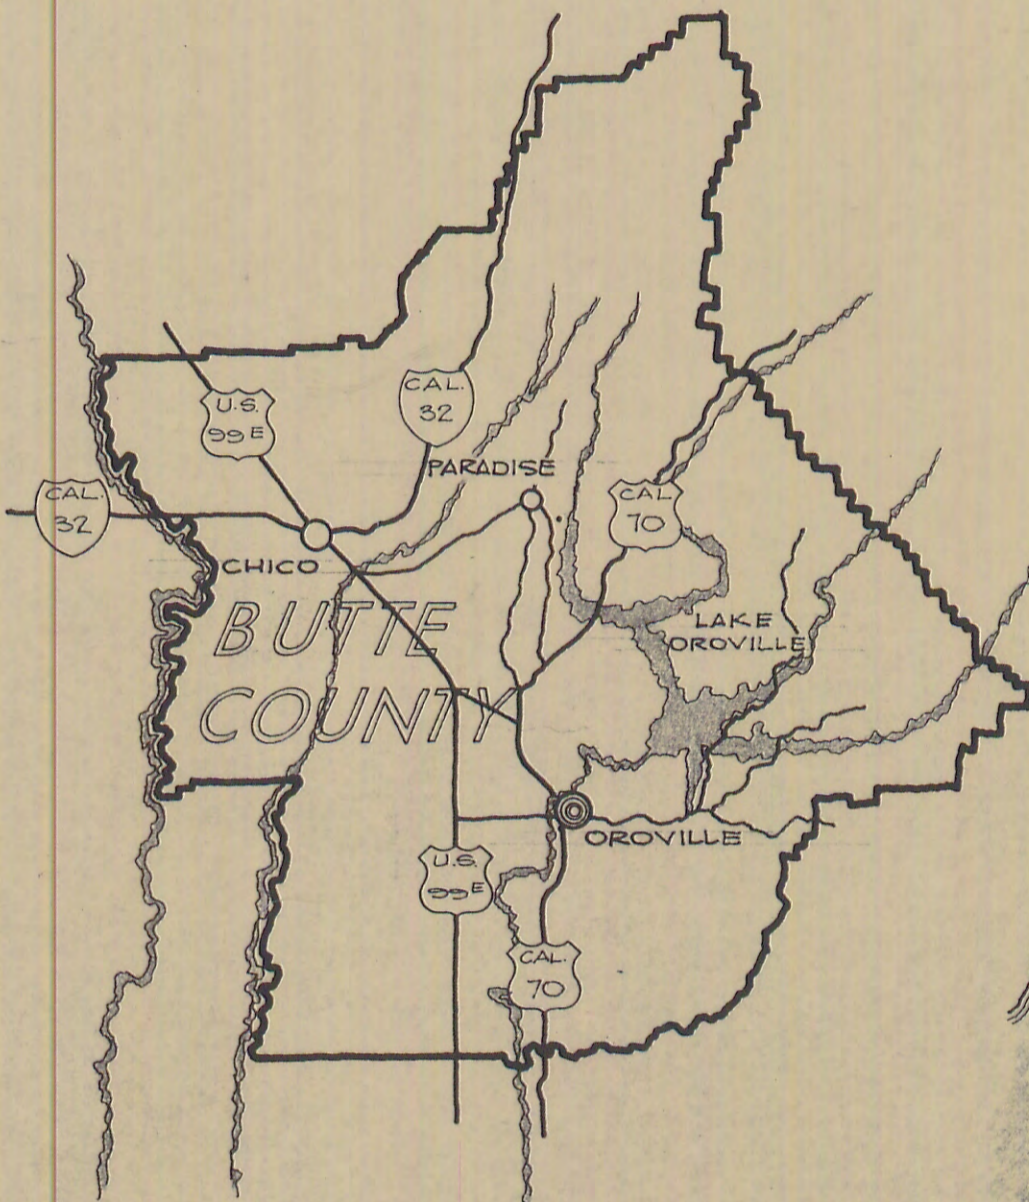

72032


COOK ASSOCIATES
ENGINEERING CONSULTANTS
OROVILLE CALIFORNIA

SUBMITTED BY:
Daniel James Cook
DANIEL JAMES COOK
P.E. No. 13062

AUTHORIZED ON THE 2ND DAY OF JULY, 1973 BY THE CITY COUNCIL OF THE CITY OF OROVILLE, BUTTE CO. CALIFORNIA. ROBERT WINSTON, MAYOR.

COMPLETED ON: 16TH DAY OF NOVEMBER, 1973
BY: J. E. McAHIS

SEWER IMPROVEMENTS FOR THE AREA ANNEXED TO THE CITY OF OROVILLE WITHIN VALLEY VIEW NO. 1 & 2 CANYON HIGHLANDS DRIVE NO. 1

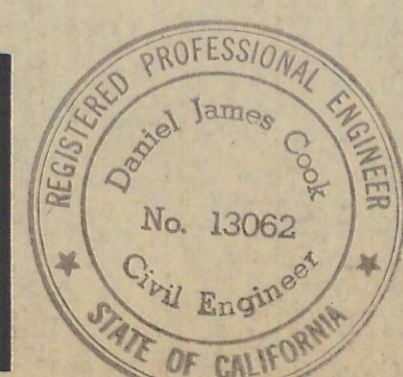

MARCH 1973
SHEET No. 1 OF 5 SHEETS

99262