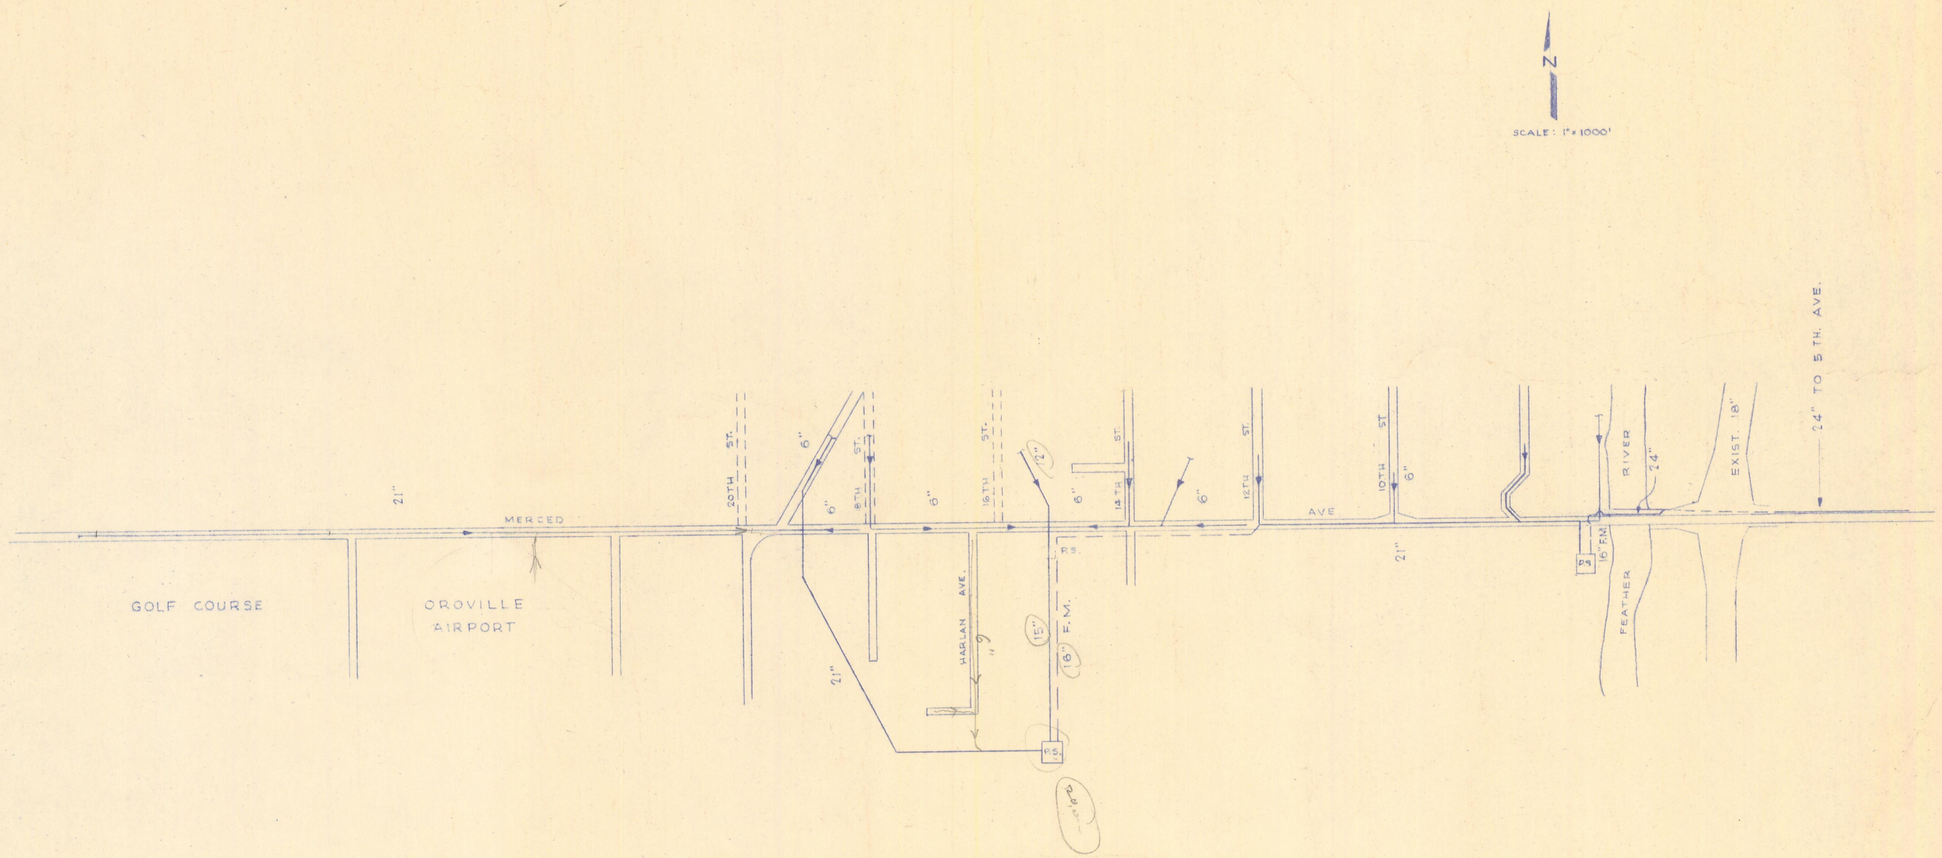

CITY OF OROVILLE
MERCED AVE. SEWER EXTENSION

SS-249
~~ST 483~~