
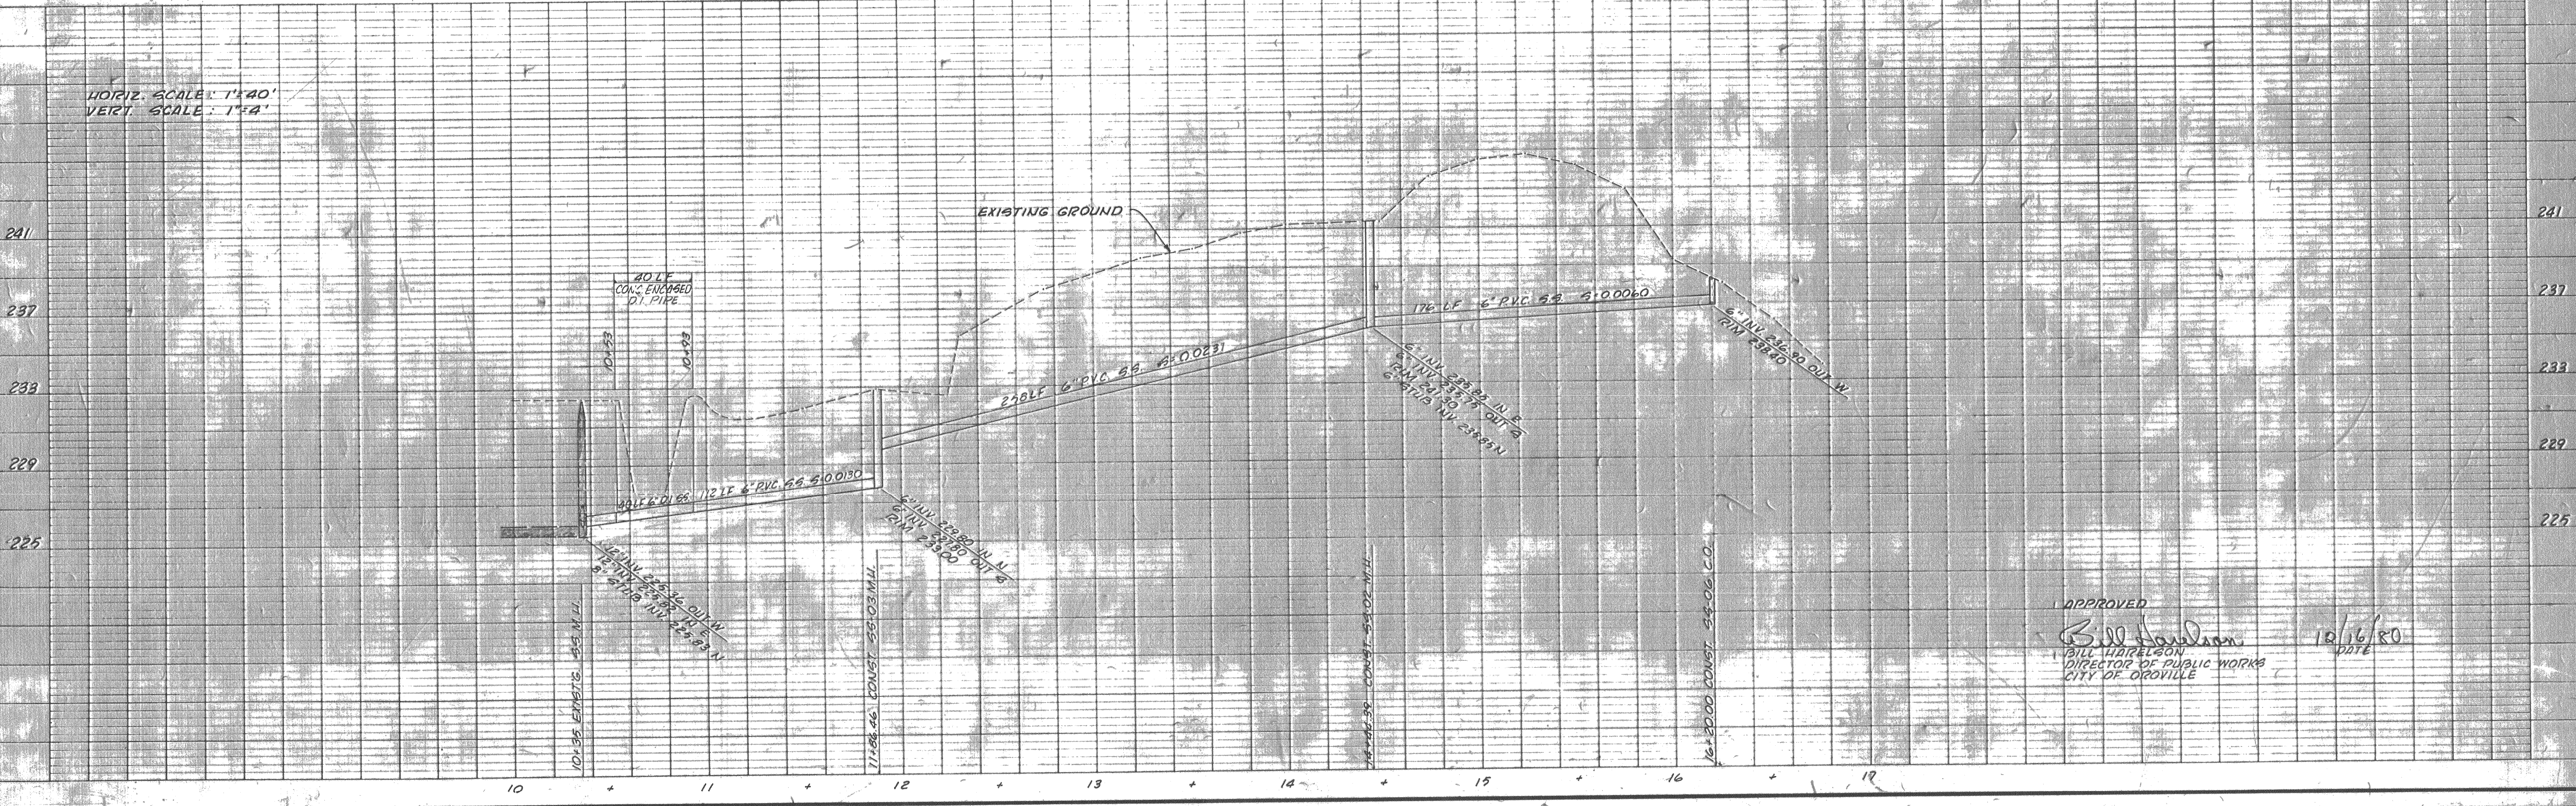
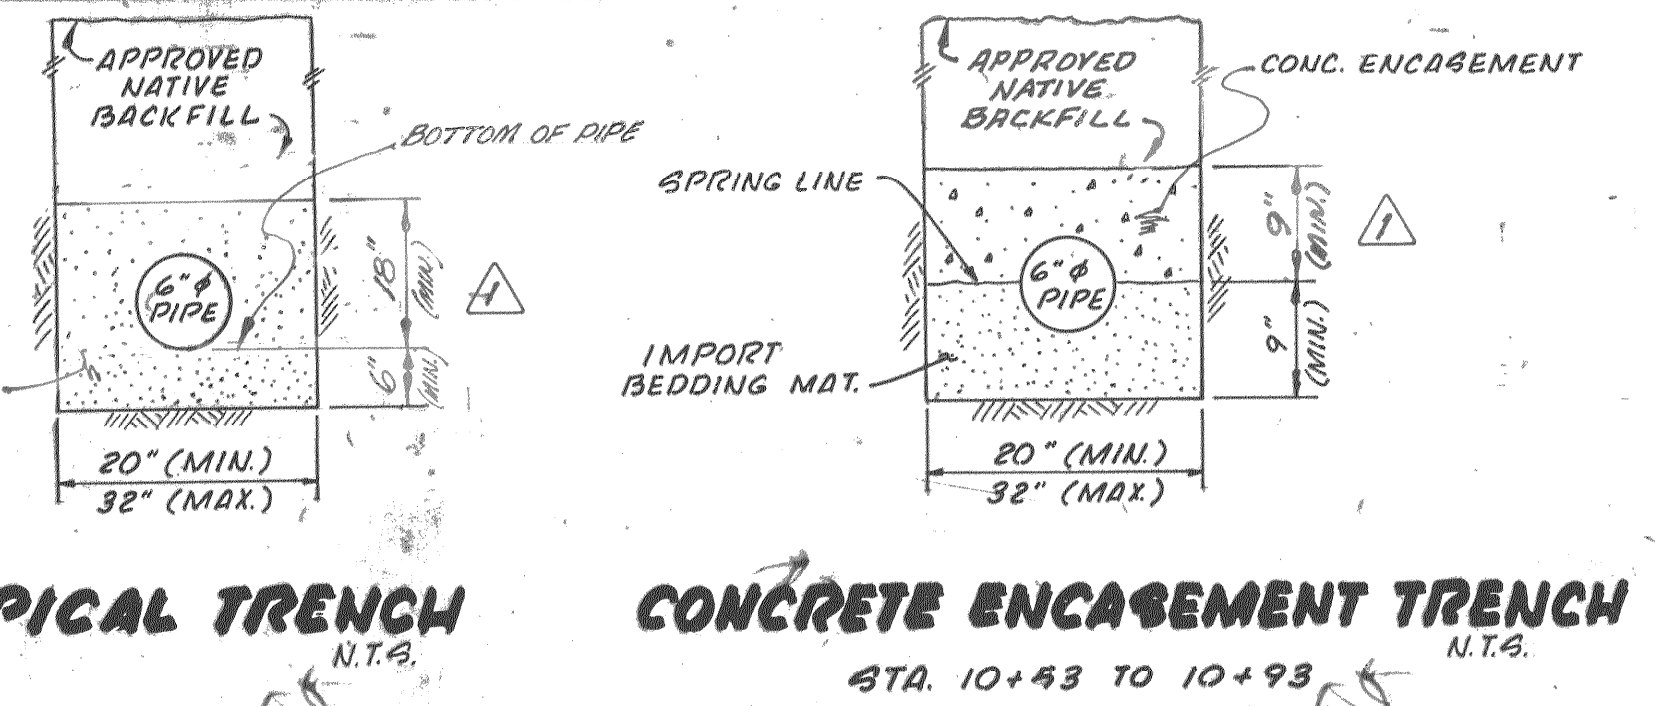


GENERAL NOTES

- ALL MATERIALS AND CONSTRUCTION SHALL BE IN STRICT COMPLIANCE WITH REQUIREMENTS OF THE CITY OF OROVILLE.
- APPROVAL OF CITY ENGINEER OR HIS AUTHORIZED REPRESENTATIVE IS REQUIRED ON COMPLETED WORK PER 91A.01.
 - PLACING OF ANY CONCRETE
 - PLACING OF APPROPRIATE MAN
 - BACKFILLING TRENCHES FOR DRAINAGE PIPE
 - PLACING OF ASPHALTIC CONCRETE
- WORK DONE WITHOUT SUCH APPROVAL SHALL BE DONE BY THE CONTRACTOR'S RISK. SUCH APPROVAL, WHEN GIVEN, SHALL NOT RELIEVE THE CONTRACTOR FROM THE RESPONSIBILITY OF REPERFORMING THE WORK IN AN ACCEPTABLE MANNER.
- THE TYPE, LOCATION, DEPTH AND/OR DEPTH OF EXISTING UNDERGROUND UTILITIES, AS SHOWN ON THESE IMPROVEMENT PLANS, HAVE BEEN OBTAINED FROM RECORDS OF THE CITY OF OROVILLE. THE CONTRACTOR IS CAUTIONED THAT ONLY ACTUAL EXCAVATION WILL REVEAL THE NUMBER, TYPE, DEPTH, SIZE, LOCATION AND DEPTH OF SUCH UNDERGROUND UTILITIES. A RESPONSIBLE PERSON HAS BEEN PLACED TO LOCATE AND DELINEATE ALL KNOWN UTILITIES. HOWEVER, THE CONTRACTOR'S ASSOCIATES OR ASSOCIATES HAS NO RESPONSIBILITY FOR THE COMPLETENESS OR ACCURACY OF SUCH INFORMATION OR FOR ANY UNDERGROUND UTILITIES NOT SHOWN ON THESE IMPROVEMENT PLANS OR FOR THE INTERFERENCE OF OTHER KNOWN UTILITIES WHICH MAY BE ENCOUNTERED, BUT WHICH ARE NOT SHOWN ON THESE IMPROVEMENTS.
- THE CONTRACTOR IS HEREBY NOTIFIED THAT PRIOR TO COMMENCING CONSTRUCTION, HE IS RESPONSIBLE FOR CONTACTING THE UTILITY COMPANIES INVOLVED AND REQUESTING A VERIFICATION OF THE LOCATION OF THE LOCATIONS OF THEIR UNDERGROUND UTILITIES WHERE SUCH UTILITIES MAY POSSIBLY COMPLY WITH THE PLACEMENT OF IMPROVEMENTS AS SHOWN ON THESE IMPROVEMENT PLANS.



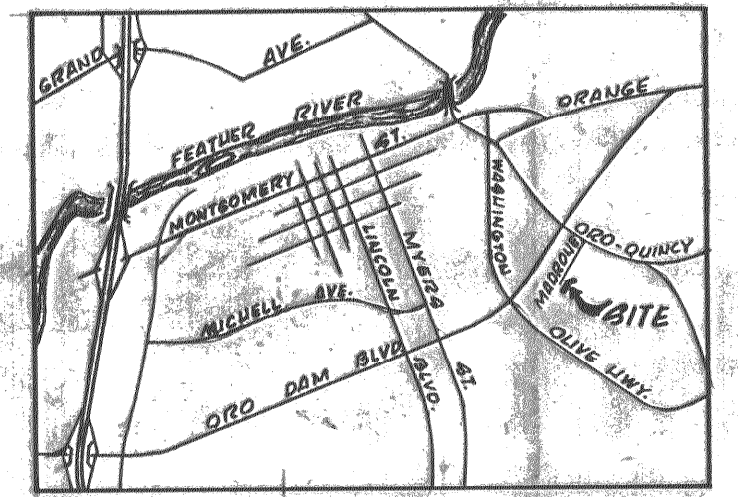

APPROVED
 Bill Harbison
 DIRECTOR OF PUBLIC WORKS
 CITY OF OROVILLE
 12/16/80
 DATE

REVISIONS DATE NO REVISION BY APP'D		FIELD BOOK ELEVATION DATUM 13M ELEVATION 233.89 12\" R/S SPIKE 0.5\" IN G. FACE J.P. #5, 30\" RT. ORO DAM BLVD. @ STA. 98+13.20 CITY OF OROVILLE DATUM.	DRAWN R.A.S. DESIGNED R.C.L. CHECKED K.C.L. SCALE AS SHOWN		EDDIS DRISCOLL AND ASSOCIATES ENGINEERING SURVEYING PLANNING 463 ORO DAM BLVD. SUIT 500 OROVILLE, CALIF. 95965 (916) 838-2068	MADRONE AVE. SOUTH SANITARY SEWER IMPROVEMENTS CITY OF OROVILLE	SHEET 1 OF 1 SHEETS JOB NO. 80-097 REVISED 9.81 PAVING 55-290
---	--	--	---	--	--	---	--