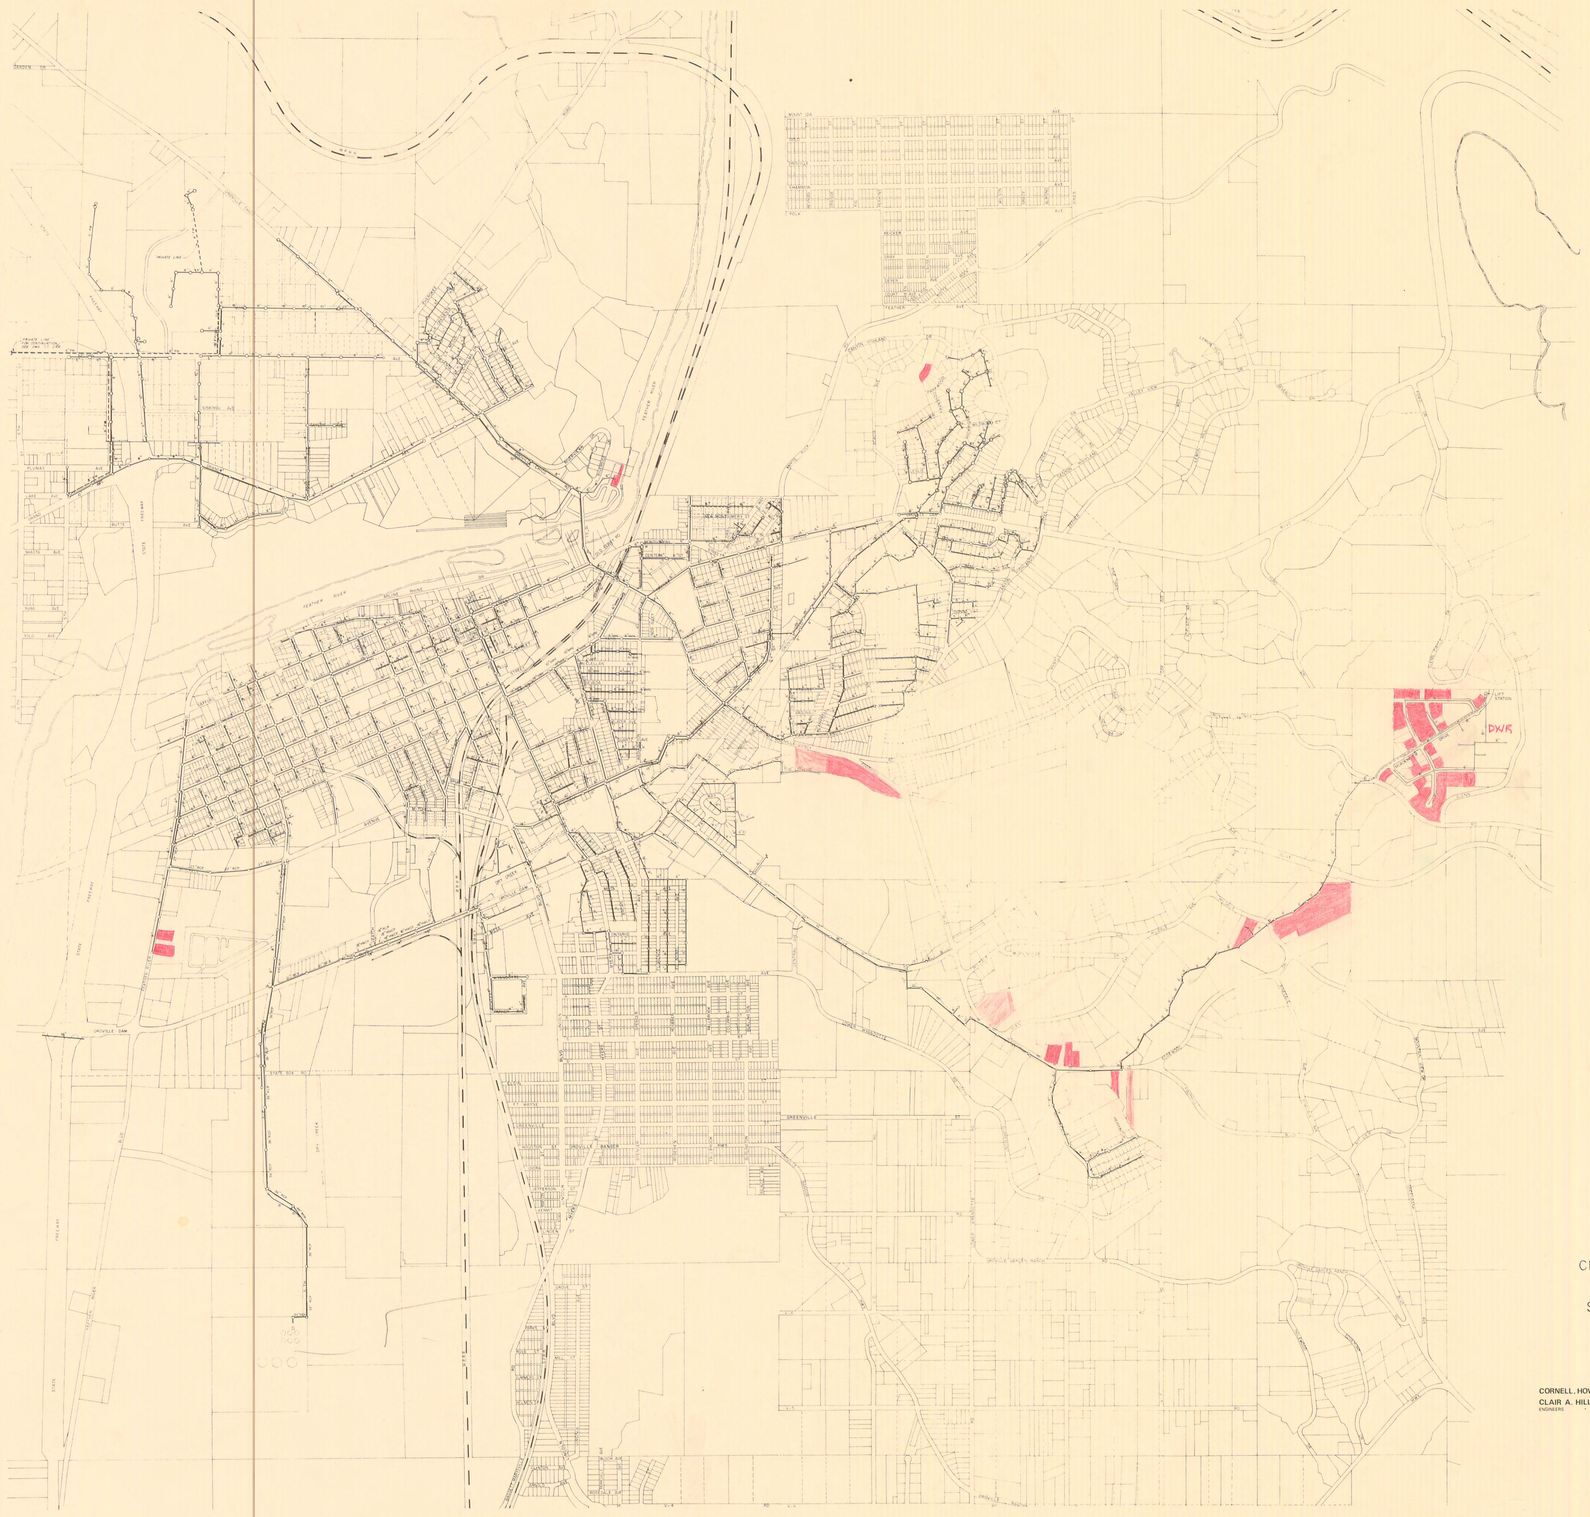

CITY OF OROVILLE

SANITARY
SEWER SYSTEM

11 FEBRUARY 1974

CORNELL, HOWLAND, HAYES & MERRYFIELD
CLAIR A. HILL & ASSOCIATES
ENGINEERS · PLANNERS · ECONOMISTS

CH2M HILL

OUTSIDE SEWED SERVICES

SS-267