

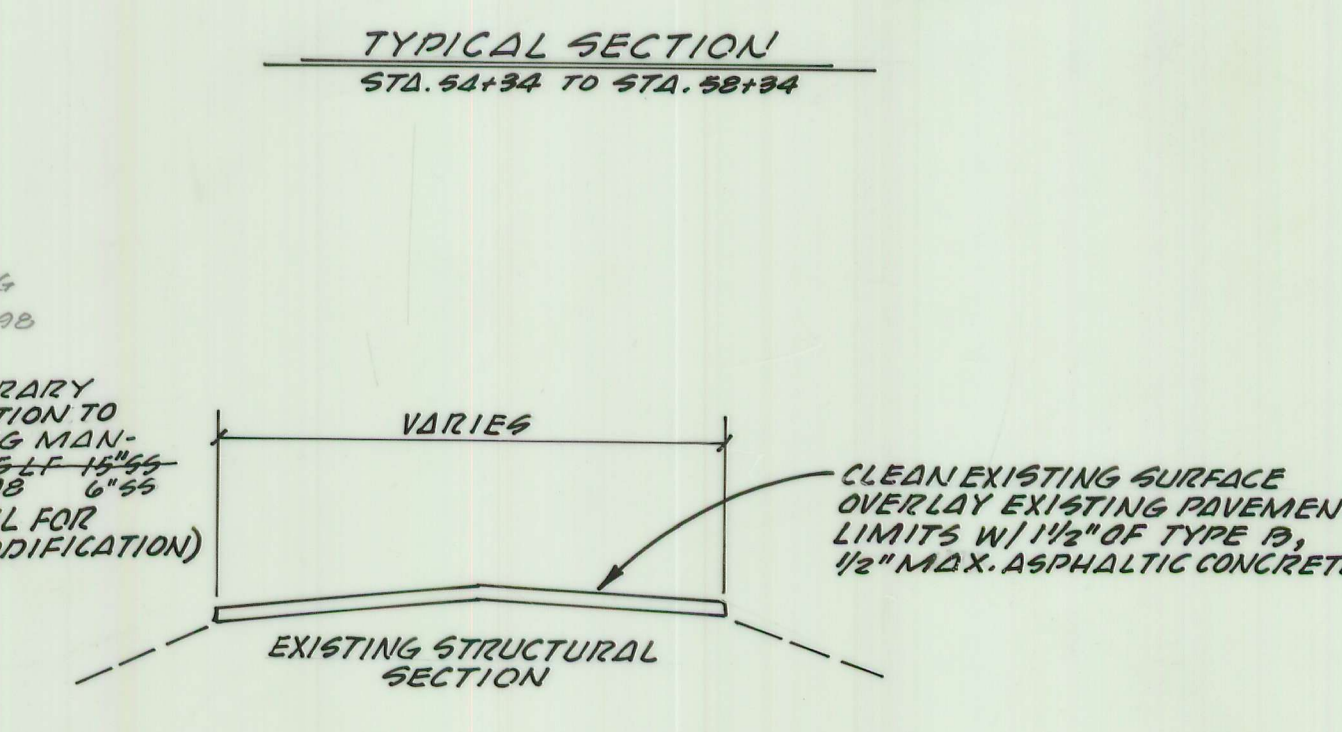
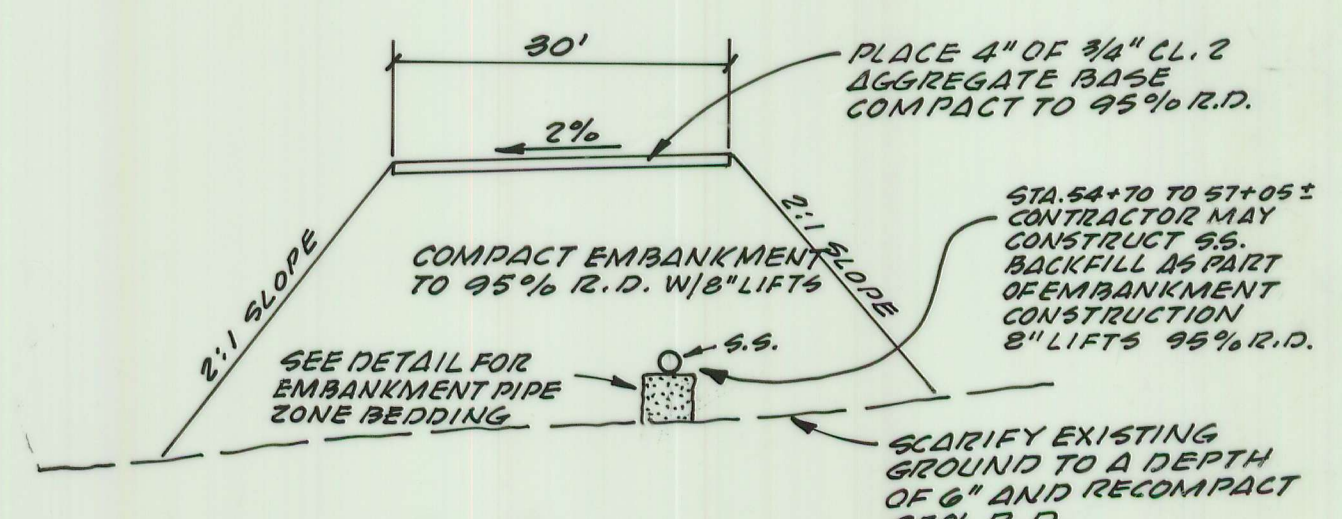
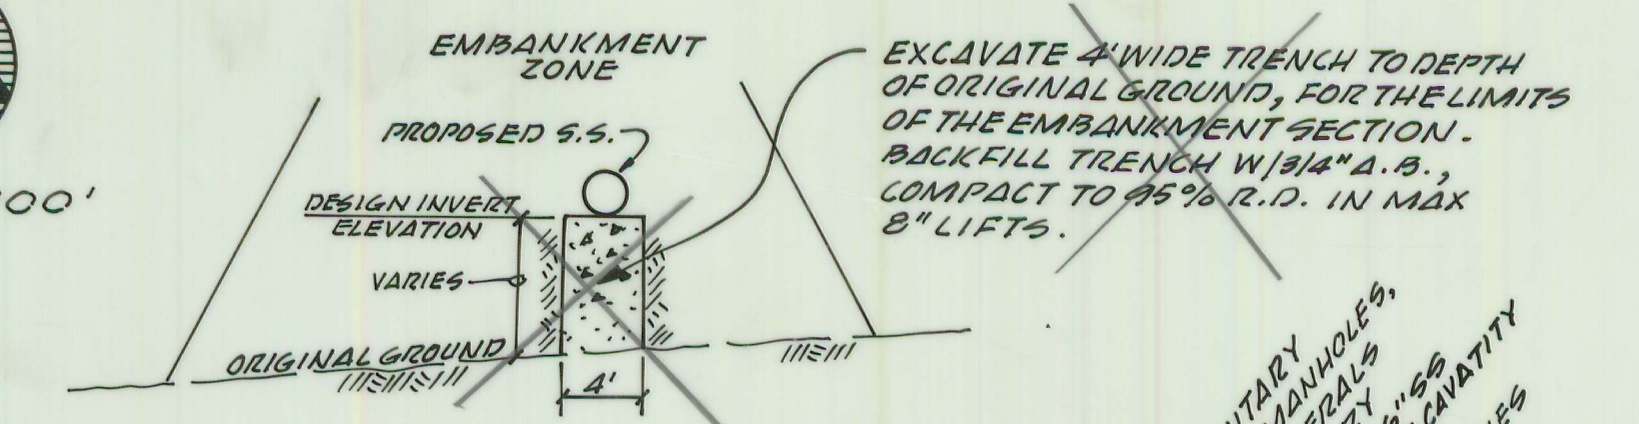


QUAIL RUN SUBDIVISION (TENTATIVE)

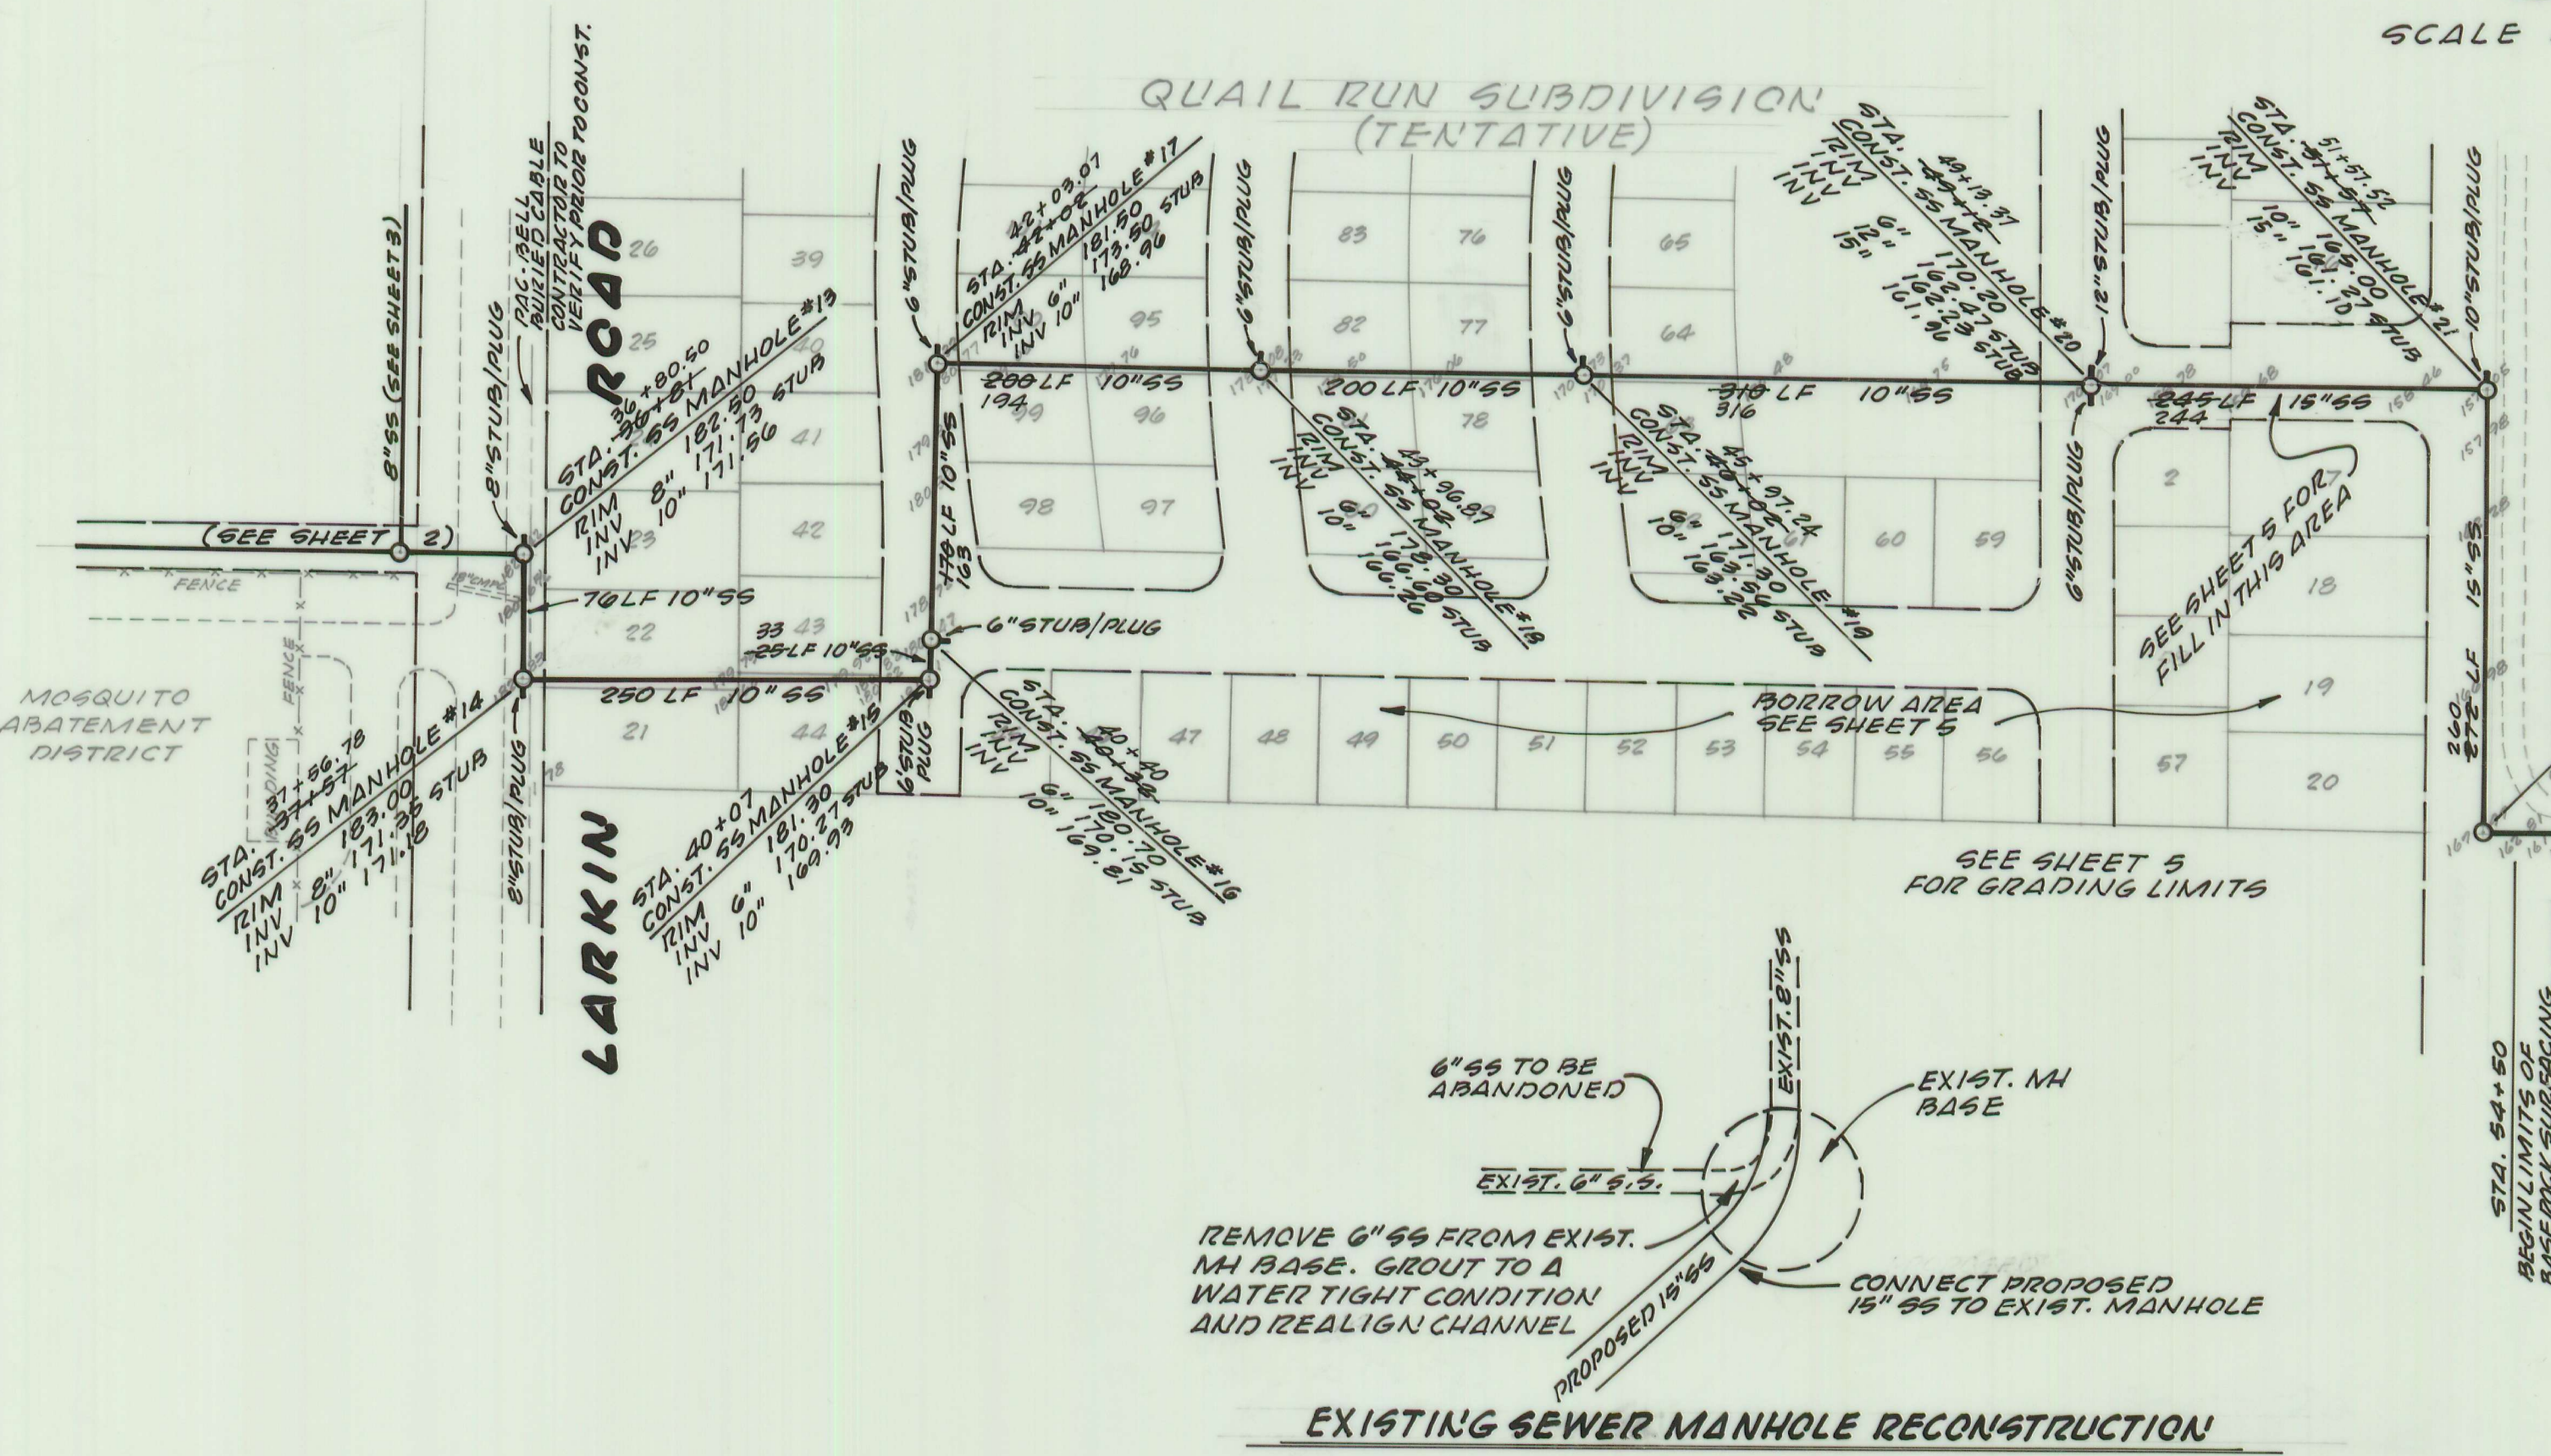

EXISTING SEWER MANHOLE RECONSTRUCTION

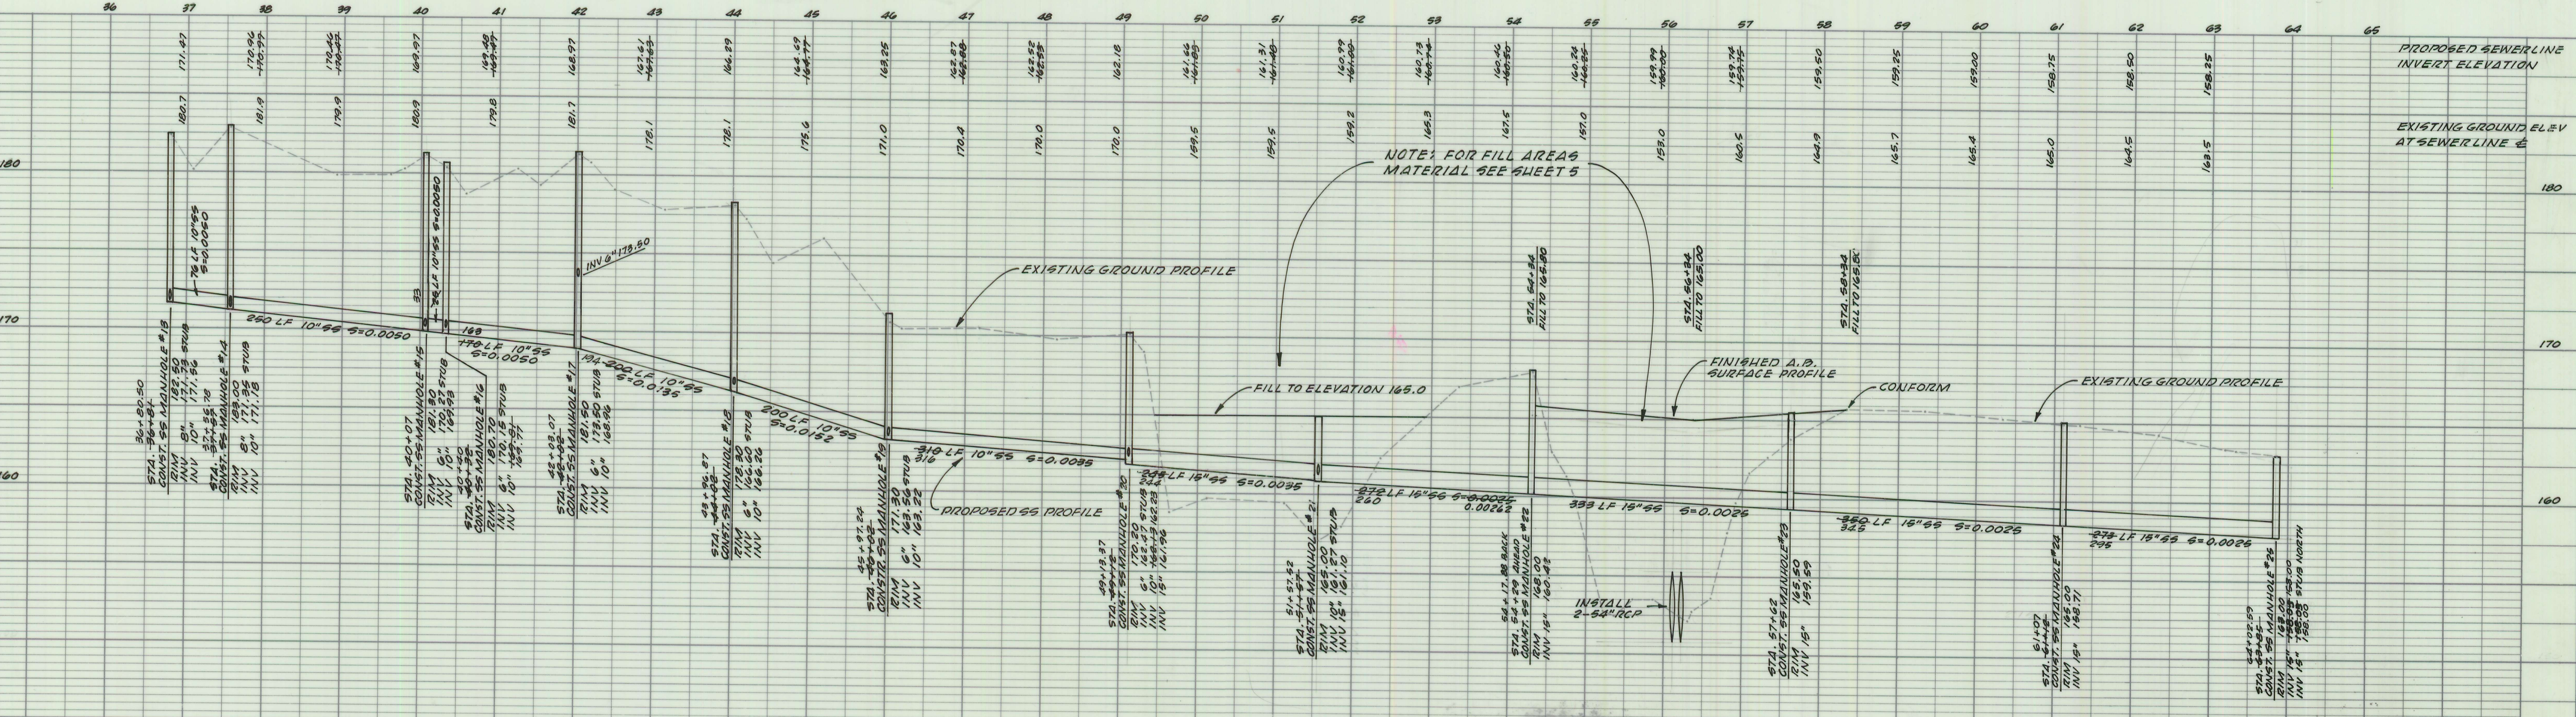

DATE	NO.	REVISION	BY	APP'D

FIELD BOOK	DRAWN
ELEVATION DATUM	LANE
	DESIGNED
	CHECKED
	SCALE AS SHOWN
APPROVED	DATE

Barnhart Brown & Associates
 A CALIFORNIA CORPORATION
 P.O. Box 1576
 Oroville, CA 95965
 916/534-1911
 CIVIL ENGINEERS • LAND SURVEYORS

**CITY OF OROVILLE
 OROVILLE MUNICIPAL AIRPORT
 SEWER EXTENSION**