PLAN SURVEYED / PLOTTED / NOTE BOOK / No. / DRAWING CHECKED / AT OF MAY CHECKED / BY / DATE

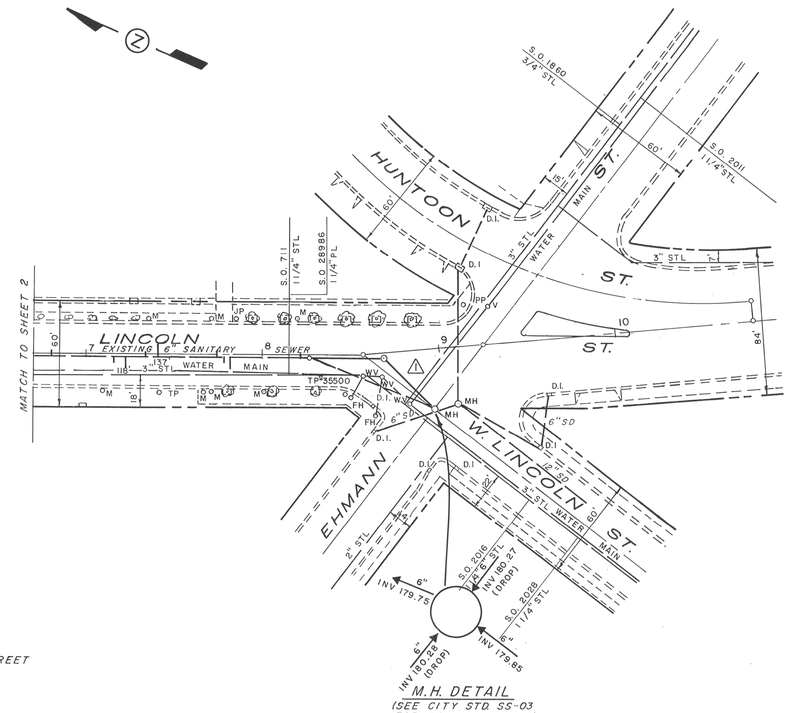

M.H. DETAIL
(SEE CITY STD. SS-03 FOR DROP MANHOLE)

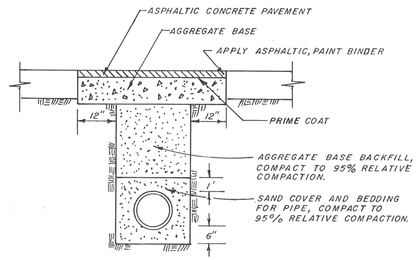

TYPICAL TRENCH DETAIL
N.T.S.

BENCHMARK

R.R. SPIKE IN J.P.
WEST SIDE OF LINCOLN STREET
STA. 8+47.00 RT.
ELEV. 190.01

SCALE
HORZ. 1"=40'
VERT. 1"=4'

PROFILE SURVEYED / PLOTTED / NOTE BOOK / No. / GRADES CHECKED / B.M.'s NOTED / STRUCTURE NOTATIONS CHECKED / BY / DATE

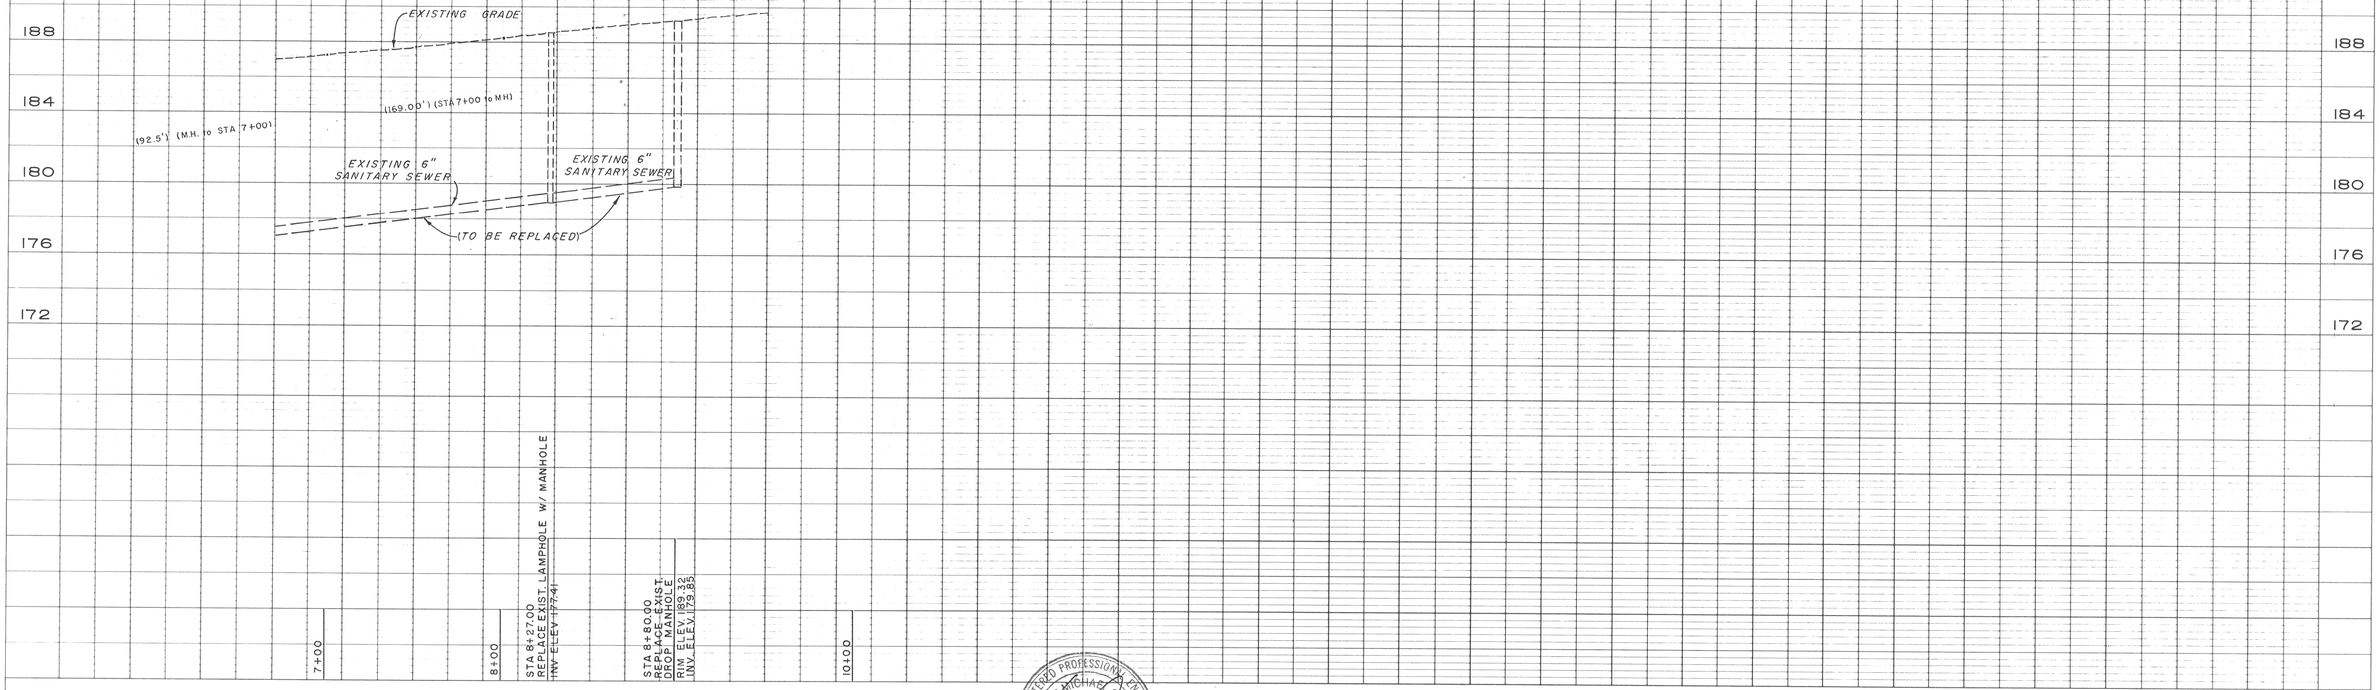

REGISTERED PROFESSIONAL ENGINEER JOHN MICHAEL JUNEAU No. C 041977 EXP 3/31/92 CIVIL STATE OF CALIFORNIA

DATE	NO.	REVISION	BY	APP'D
1-7-94	1	S.S. LATERALS, WATER MAIN & GAS	T.F.	

FIELD BOOK
ELEVATION DATUM
DRAWN T.F.
DESIGNED J.J.
CHECKED J.J.
SCALE

APPROVED
DIRECTOR PUBLIC WORKS R.C.E. 41977 — 5/5/93 DATE

CITY OF OROVILLE
PUBLIC WORKS DEPARTMENT
1675 MONTGOMERY ST.
OROVILLE, CA 95965 (916) 538 - 2420

SANITARY SEWER REPLACEMENT PROJECT
LINCOLN STREET AND EHMANN STREET

SHEET 3 OF 4 SHEETS
JOB NO.

SS - 330